

CORNER REPORT FORM

Section 29 Township 29S Range 1W
Douglas County Date April, 2010

CORNER DESIGNATION

South 1/16 30 29

- Condition Report only
- Not Found
- Renewed
- Unrecorded
- Surveyed In
- Referenced out

Previous Renewals/Surveys, etc:

M 42-39

Monument(s) & Accessories Found: (Condition and Source)


Brass capped iron pipe per M 42-39. Good.

Chinquapin to NW per M 42-39 is broken off.

11" diam D. Fir bears S.56°E., 8.9' with healed blaze.

Monument Detail

Sketch

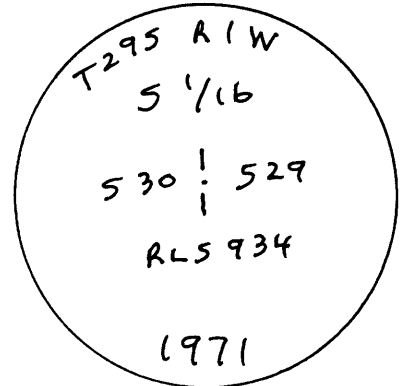

Monument Set (Procedures and Description)

N/A

New Accessories

A 17" diam. D. Fir bears N.26°W., 17.75 feet. Scribed S 1/16 S30 BT.

A 6 foot steel post is set 2 feet North.

Location & Comments

Surveyor's Seal

FILED

Date: 4-22-2010 By: JC

Compass Declination 18°

Firm/Agency: David Edwards Land Surveying

Address: P.O. Box 361
Oakland, OR. 97462



This survey consists of:

Map: _____


Narrative: _____

Corner Rpt: CS 65/69-16

Party Chief: Brant Miller

Notes:

Witness: Eric Sprinkle

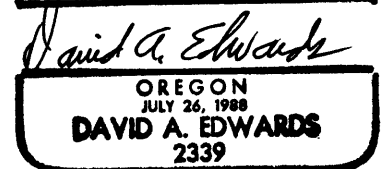

DOUGLAS COUNTY SURVEYOR

C.S. File No 65/69-16

Renews 12/31/2011