

OREGON CORNER RESTORATION FORM

Section 27 Township 25 S. Range 5 W.  
 County Douglas Date 4/28/10

**FILED**  
 Date: 5/10/2010 By: JC  
 This survey consists of:  
 Map: \_\_\_\_\_  
 Narrative: \_\_\_\_\_  
 Corner Rpt: 65/69-18

**DOUGLAS COUNTY  
 SURVEYOR**

Corner Designation

T. 25 S. R. 5 W.



- \_\_\_\_\_ Condition Report Only
- \_\_\_\_\_ Not Found
- X \_\_\_\_\_ Renewed
- \_\_\_\_\_ Unrecorded
- \_\_\_\_\_ Surveyed In
- \_\_\_\_\_ Referenced Out


Previous Renewals/Surveys, etc.  
 Map M137-29

Douglas County Surveyors Office CS 56/28 & CS 64/75-28

Monument(s) & Accessories Found: (Condition and Source)


- Found 5/8" Iron Rod
- 23" Douglas Fir Stump Bears S84°E 49.7 Ft. As Per Record Healed Face We Tag (Basis Of Bearing)
- 20" Madrone Stump Bears S37°E 18.0 Ft. (Record S36 3/4°E 17.9 Ft.) Healed Face We Tag
- 14" Rotten Stump We Drive 5/8" x 40" Iron Rod In Middle Of Stump Bears N28 3/4°W 11.6 Ft.
- (Record N28 1/2°W 11.7 Ft.) Iron Rod Has Yellow Plastic Cap Marked Lone Rock Timber PLS 2291
- Put Metal Fence Post Approx. 0.2 feet North Of Iron Rod In Stump.

Monument Detail

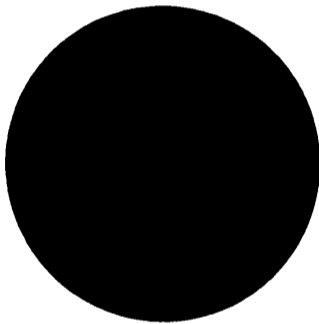

5/8" Iron Rod

Sketch

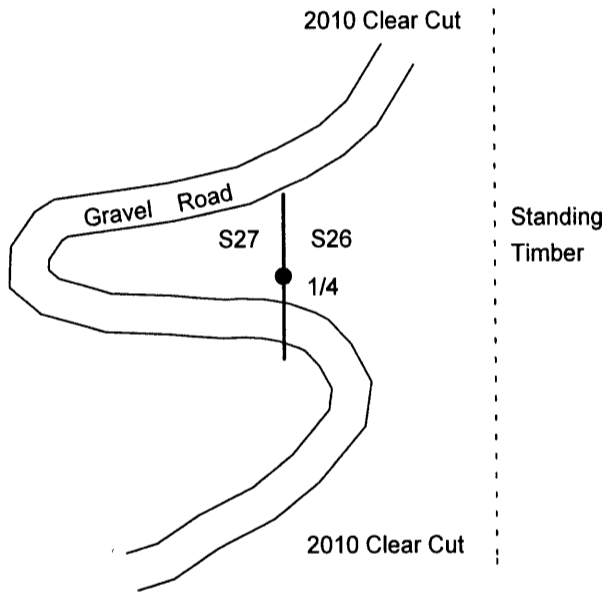

Monument Found  
 Found 5/8" Iron Rod

New Accessories

21" Douglas Fir Stump With Edges Cut Off Bears S44 1/2°W 11.1 Ft. Put P K Nail In Top Of Stump & Tag

Location & Comments

Corner is 0.5 ft. ground level  
 approx. 30 feet north of  
 switchback in gravel road.  
 Put metal fence post approx.  
 0.5 feet north of corner.

Bearing Basis From record 23" Douglas Fir stump  
 Firm/Agency Lone Rock Timber Co.  
 Address P. O. Box 1127  
Roseburg, Ore. 97470  
 Party Chief Ken W. Hoffine  
 Notes G. Angiolet  
 Witness \_\_\_\_\_

REGISTERED  
**PROFESSIONAL  
 LAND SURVEYOR**  
  
 OREGON  
 JULY 16, 1987  
**KEN W. HOFFINE**  
 PLS 2291

EXPIRES 6-30-11

C.S. File No 65/69-18