

FILED

Date: 6/14/2010 By: Jc

This survey consists of:

Map: _____

Narrative: _____

Corner Rpt: 65/69-24

CORNER REPORT FORM

Section 8 Township 24 South Range 6 West

Douglas County Date: 6/1/2010

Corner Designation

- Condition Report Only
- Not Found
- Renewed
- Unrecorded
- Surveyed In
- Referenced Out

DOUGLAS COUNTY
SURVEYOR

Previous Renewals/Surveys, etc. See T 24 S, R 6 W, Card 200500

Monument (s) & Accessories Found: (Condition and Source)
 BLM Aluminum Cap dated 2003 with the following Accessories;
 Decayed Fir Stump Bears N18-1/2°E, 42.9' no marks visible
 27" Fir Stump Bears S33-3/4°E, 63.1' healed face
 27" Fir Stump Bears S65-3/4°W, 60.7' no marks visible
 12" Madrone Bears N8-3/4°E, 45.2' healed double blaxe
 25" Fir bears N37-1/2°W, 47.1' healed double blaze
 16" Fir Bears S18-1/4°W, 89.9' healed face (unrecorded BLM)
 18" Fir Bears S11-3/4°E, 78.6' healed face (unrecorded BLM)

Monument Detail

Sketch

T24S R6W
 S 7 | S 8
 S18 | S17
 2003


Monument Set (Procedures and Description)

New Accessories

Location & Comments

Compass Declination: 17-1/2°E
 Firm/Agency: Ward NorthWest Inc.
 Address: P.O. Box 105, Florence, OR 97439
 Party Chief: Ron Rice
 Notes:
 Witness: Josh Reed

Surveyor's Seal

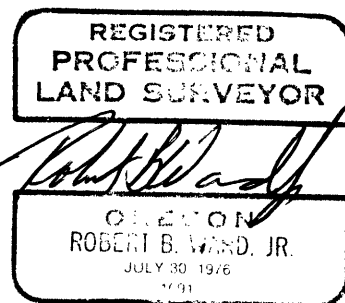

Renew 6/30/12

C.S. File No 65/69-24