

CORNER REPORT FORM
Section 32 Township 23 South Range 6 West
Douglas County Date: 6/1/2010

FILED
Date: 6/14/2010 By: JC
This survey consists of:
Map: _____
Narrative: _____
Corner Rpt: 65/69-25

Corner Designation $\frac{1}{4}$ Corner S32/S5

- Condition Report Only
- Not Found
- Renewed
- Unrecorded
- Surveyed In
- Referenced Out

DOUGLAS COUNTY
SURVEYOR

Previous Renewals/Surveys, etc. See T 23 S, R 6 W, Card 240100

Monument (s) & Accessories Found: (Condition and Source)
BLM Brass Cap dated 1957 with the following Accessories;
66" Fir Stump Bears N48°E, 38.9' healed face
34" White Fir Bears S61°W, 52.5' healed face (BLM reported as Hemlock)
20" Hemlock Bears S40-1/2°E, 30.7' healed face

Monument Detail

Sketch

T23S R6W
S32
1/4 —
S5
T24S R6W
1957


Monument Set (Procedures and Description)

New Accessories

Location & Comments

Compass Declination: 17-1/2° E
Firm/Agency: Ward NorthWest Inc.
Address: P.O. Box 105, Florence, OR 97439
Party Chief: Ron Rice
Notes:
Witness: Josh Reed

Surveyor's Seal

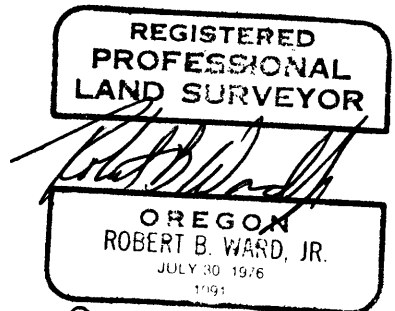

Renew 6/30/12

C.S. File No 65/69-25