

FILED

Date: 6/14/2010 By: JC  
This survey consists of:  
Map: \_\_\_\_\_  
Narrative: \_\_\_\_\_  
Corner Rpt: 65/69-27

CORNER REPORT FORM

Section 32 Township 23 South Range 6 West  
Douglas County Date: 6/1/2010

Corner Designation One-quarter Corner 29 / 32

DOUGLAS COUNTY  
SURVEYOR

- \_\_\_\_\_ Condition Report Only
- \_\_\_\_\_ Not Found
- Renewed
- \_\_\_\_\_ Unrecorded
- \_\_\_\_\_ Surveyed In
- \_\_\_\_\_ Referenced Out

Previous Renewals/Surveys, etc. See T 23 S, R 6 W, Card 240200

Monument (s) & Accessories Found: (Condition and Source)

BLM Brass Cap dated 1994 with the following Accessories;  
14" Fir Bears N4-1/4°E, 23.1' healed face  
13" Fir Bears S61-1/2°E, 7.3' healed face  
Erroneously corrected Brooks corner Bears N1°57'00"E, 69.9'

Monument Detail

Sketch

T23S R6W  
S29  
1/4 \_\_\_\_\_  
S32  
1994

Monument Set (Procedures and Description)


New Accessories

21" Madrone Bears N33°W, 6.7' scribed "1/4 S29 BT

Location & Comments

Compass Declination: 17-1/2° E  
Firm/Agency: Ward NorthWest Inc.  
Address: P.O. Box 105, Florence, OR 97439  
Party Chief: Ron Rice  
Notes:  
Witness: Josh Reed

Surveyor's Seal

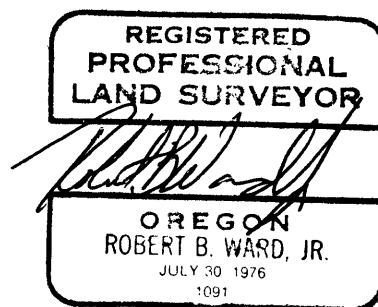

Renew 6/30/12