

FILED

Date: 7/7/2010 By: JC
This survey consists of:

Map: _____
Narrative: _____
Corner Rpt: CS 65/69-36

CORNER REPORT FORM

Section 6 Township 24 South Range 6 West
Douglas County Date: 6/28/2010

DOUGLAS COUNTY
SURVEYOR

Corner Designation

- Condition Report Only
- Not Found
- Renewed
- Unrecorded
- Surveyed In
- Referenced Out

Previous Renewals/Surveys, etc. See T 24 S, R 6 W, Card 140600

Monument (s) & Accessories Found: (Condition and Source)

- 21" D. Fir bears N72°E, 32.3' (healed face)
- 23" Hemlock bears S52°E, 39.3' (healed face)
- 28" rotting stump bears S22°40'E, 32.3' (visible scribing)
- 17" D. Fir bears S78°W, 44.5' (healed face)
- 20" D. Fir bears N38°W, 44.8' (healed face)

Monument Detail

Sketch

County Surveyors Office
T24S R6W
S6
1/4 _____
S7
1960


Monument Set (Procedures and Description)

New Accessories

Location & Comments

Compass Declination:
Firm/Agency: Ward North West Inc.
Address: P.O. Box 105, Florence, OR 97439
Party Chief: Ron Rice
Notes:
Witness: Josh Reed

Surveyor's Seal

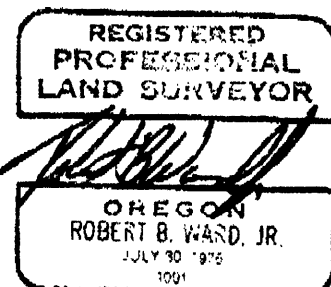

Renew 6/30/12

C.S. File No 65/69-36