

CORNER REPORT FORM

Section 26 Township 22 S Range 6 W
Douglas County Date 7/22/2010

CORNER DESIGNATION

West 1/4 Corner Section 26 only.

- Condition Report only
- Not Found
- Renewed
- Unrecorded
- Surveyed In
- Referenced out

Previous Renewals/Surveys, etc:

1855 G.L.O. survey; 1963 B.L.M. Dependent Resurvey

Monument(s) & Accessories Found: (Condition and Source)


- 1963 B.L.M. Brass Cap
- 72" Cedar stump bears N.40°E., 30 links
- 20" Fir stump bears S63 1/2°E., 48 links
- 11" Madrone bears N.55 1/2°W., 25 links

FILED
 Date: 8/10/2010 By: JC
 This survey consists of:
 Map: _____
 Narrative: _____
 Corner kpt: CS 65/69-49

DOUGLAS COUNTY
SURVEYOR

Monument Detail

Sketch

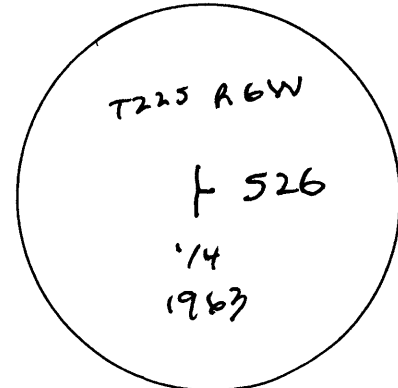

Monument Set (Procedures and Description)

N/A


New Accessories

scribe a 14" diam. Fir "T22S R6W S26 BT" which bears N.45°E., 7.80 feet.
Set a 6 foot steel post 2' North

Location & Comments

Surveyor's Seal

Compass Declination 19°
Firm/Agency:
 David Edwards Land Surveying
Address: P.O. Box 361
 Oakland, Oregon 97462
Party Chief: Brant Miller
Notes:
Witness: Eric Sprinkle

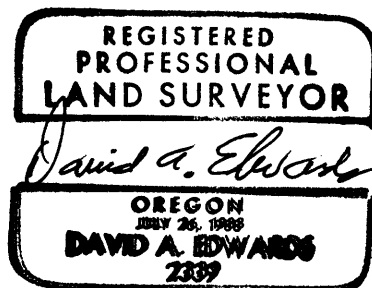

C.S. File No 65/69-49