

CORNER REPORT FORM

Section 12 Township 24S Range 8W
Douglas County Date: April 1996

CORNER DESIGNATION:

1/4 Corner Sections 12 - 13

Previous Renewals/Surveys, etc:


GLO Survey - Chandler, 1893, Page 3322
BLM Survey - Corbin, June 1959, Page 12611

___	Condition Report only
___	Not Found
<u>X</u>	Renewed
___	Unrecorded
___	Surveyed In
___	Referenced out

Monument(s) & Accessories Found: (Condition and Source)

18" D. Fir N77 1/2°E 13.2' Healed Face BLM 1959
72" D. Fir South 33.0' 20'tall snag GLO 1893
24" Hemlock S60 1/2°W 10.6' Visible Scribe BLM 1959

Monument Detail Sketch:

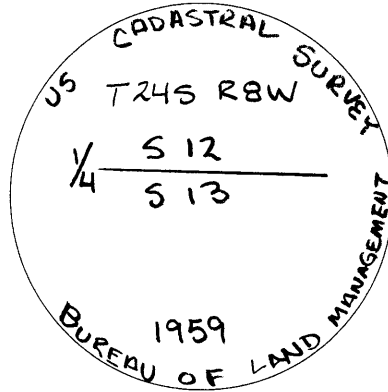

Monument Set: (Procedures and Description)

New Accessories:

22" D. Fir N5°E 5' - Scribed "1/4 S BT"
20" D. Fir S9°W 23.6' - Scribed "1/4 S BT"

Location & Comments:

Compass Declination: 18°
Firm/Agency: Roseburg Forest Products
Address: PO Box 1088
Roseburg, OR 97470
Party Chief: William Olson
Notes:
Witness: Ralph McManis

Surveyor's Seal

REGISTERED
PROFESSIONAL
LAND SURVEYOR

Mark F. Smalley

OREGON
July 26, 1988
MARK F. SMALLEY
2354

RENEWS: 6/30/2012

FILED
Date: 10/29/2010 By: JC
This survey consists of:
Map: _____
Narrative: _____
Corner Rpt: CS 65/69-51
DOUGLAS COUNTY
SURVEYOR

C.S. File No 65/69-51