

CORNER REPORT FORM

Section 9 Township 27S Range 7W
Douglas County Date Nov. 11, 2010

Date: 12-17-2010 By: JC
This survey consists of
Map: _____

CORNER DESIGNATION

SOUTH 1/4 COR SEC 9

- ___ Condition Report only
- ___ Not Found
- ___ Renewed
- ___ Unrecorded
- Surveyed In
- ___ Referenced out

Narrative:
Corner Rpt: CS 65/69-64

DOUGLAS COUNTY
SURVEYOR

Previous Renewals/Surveys, etc:


Monument(s) & Accessories Found: (Condition and Source)

FOUND COMMON SEC CORNER (300500) OF SEC. 8, 9, 16, 17
PER RECORD. FOUND BRASS CAP MON. @ 5/8" REBAR PER
RECORD AS W.C. TO COMMON SEC. CORNER OF 9, 10, 15, 16.
(400500)

Monument Detail

Sketch

SET 2" ALUM CAP ON 5/8" X 30" REBAR
ON LINE @ MIDPOINT BETWEEN SW. COR
OF SECTION 9 AND SE COR. SECTION 9
8" CEDAR @ 134° W. OAK
20" W. OAK @ 55° W 20°
5" CEDAR @ 55° E 20°
20" POST

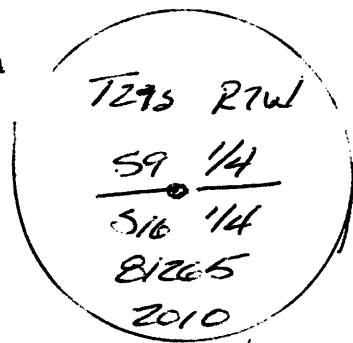

Monument Set (Procedures and Description)

RECOVERED AND LOCATED W.C. @ SE COR OF SECTION 9 &
ESTABLISHED LOCATION OF SECTION COR. OF SECTION 9, 10, 15 & 16.
RECOVERED AND LOCATED SEC. COR. @ SW. COR. OF SECTION
9. VERIFIED PER PLAT 1997-0050 & MND-27. SET 5/8" X 30" REBAR

New Accessories

WITH 2" ALUM CAP @ MIDPOINT ON LINE w/ ACCESSORIES

- SCRIBED 9" CEDAR @ N 45° W 48° w/ B.T. TAG
- SCRIBED 13" W. OAK @ N 29° E 35° w/ B.T. TAG
- SCRIBED 20" W. OAK @ S 55° W 20° w/ B.T. TAG
- 8" CEDAR FENCE CORNER POST BEARS S 55° E 20° w/ B.T. TAG

Location & Comments

Surveyor's Seal

MONUMENT LIES
NORTH OF WIRE FENCE ON
SOUTH SIDE OF OLD SKID
ROAD, WEST OF OPEN
GRASS LAND INSIDE
TIMBERED AREA.

Compass Declination
Firm/Agency: G. MARCUS BRITAIN
Address: 2670 FLORENDA VALLEY
ROSEBURG, OR, 97471
Party Chief: GMB
Notes: GMB
Witness: ROMNEY WARE

REGISTERED
PROFESSIONAL
LAND SURVEYOR

OREGON
JULY 14, 2009
GEORGE MARCUS BRITAIN
81265

C.S. File No 65/69-64

EXPIRES: 12/31/2011