


CERTIFIED RECORD OF LAND CORNER MONUMENTATION

History of original corner establishment: T. 29 S., R. 1 W., W. M.
J. A. Hoffbuhr, Land Surveyor No. 222, reestablished the One-Quarter corner of sections 29 and 32 at mid-point in 1970 on Douglas County survey map No. 40-4. He set a 2 inch diameter iron pipe with 2-1/2 inch brass cap attached, marked:
He marked bearing trees: a 6" Madrona, N. 13-1/2° E., 37.1 feet, scribed "1/4 S29 BT"; and a 13" Madrona, S. 7-1/4° E., 43.6 feet, scribed "1/4 S32 BT".

240200

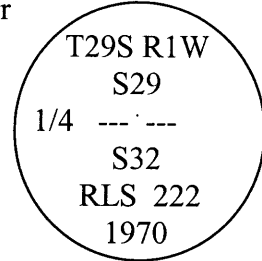

Leonard Herzstein, Deputy Douglas County Surveyor, renewed the corner in 1981 on Douglas County C.S. File No. 61/19-57. He found the 2 inch iron pipe, firmly set, projecting 6 inches above the ground, with a 2-1/2 inch brass cap marked as shown. He found the two existing bearing trees were now snags. He marked new bearing trees: a 9" W. fir., N. 67° E., 23.4 feet, scribed "1/4 S29 CSBT" on a double blaze; and a 6" D. fir, S. 21° E., 68.3 feet, scribed "1/4 S32 CSBT" on a double blaze.

Description of corner evidence found: February 22, 2011

I found a 2 inch outside diameter iron pipe, firmly set, projecting 6 inches above the ground with a 2-1/2 inch diameter brass cap marked as shown above.

From which the following bearing trees by Hoffbuhr in 1970:

- 10" diameter madrone, bears N. 13° E., 37.1 feet, with healed double blaze. Tree sprouted a new top and is alive.
- root crown, bears S. 7-1/2° E., 43.6 feet, with decayed log alongside, size indeterminate.

And the bearing trees by Herzstein in 1981:

- 13" diameter white fir, bears N. 67° E., 23.4 feet, with healed double blaze.
- 8" diameter Douglas fir, bears S. 21° E., 68.3 feet, with a healed double blaze.

Description of monument and accessories I established to perpetuate the original location of this corner:


No new measurements were taken for this corner renewal. This report is only to document the 1970 bearing tree is healthy.

Leonard E. Herzstein, L.S. 2150
Umpqua National Forest
2900 NW Stewart Parkway
Roseburg, OR 97471

My certificate expires June 30, 2011

FILED

Date: 3/17/2011 By: JC
This survey consists of:
Map: _____
Narrative: _____
Corner Rpt: CS 65/72-6

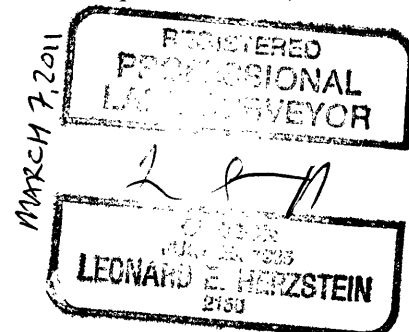

C.S. File No 65/72-6

DOUGLAS COUNTY
SURVEYOR