


CERTIFIED RECORD OF LAND CORNER MONUMENTATION

**History of original corner establishment:** T. 29 S., R. 1 W., W. M.  
Victor M. McLind, Land Surveyor No. 934, established the Center South 1/16 corner of section 29 in 1971 on Douglas County survey map No. 42-39. He set a 2 inch diameter iron pipe with 3 inch brass cap attached, marked:  
He marked bearing trees: an 18" D. fir, S. 66-1/4° E., 67.3 feet, scribed "CS 1/16 S29 BT"; and a 24" D. fir, N. 67° W., 15.8 feet, scribed "CS 1/16 S29 BT".

240220

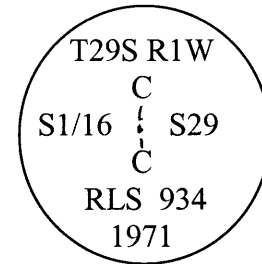

Leonard Herzstein, Deputy Douglas County Surveyor, renewed the corner in 1981 on Douglas County C.S. File No. 61/19-55. He found the 2 inch iron pipe, firmly set, projecting 4 inches above the ground, with a 3 inch brass cap marked as shown. He found the SE BT as per McLind. The NW BT was a stump. He marked a new bearing tree: a 7" I.Ced., S. 32° E., 74.3 feet, scribed "CS1/16 S29 CS BT" on a double blaze.

**Description of corner evidence found:** February 22, 2011

I found a 2 inch outside diameter iron pipe, firmly set, projecting 4 inches above the ground with a 3 inch diameter brass cap marked as shown above.

From which the following bearing trees by McLind in 1971:

- 19" diam. Douglas fir, bears S. 66-1/4° E., 67.3 feet, with fragmentary scribe marks visible on a partially healed double blaze.
- 24" diam. Douglas fir decayed stump, bears N. 67° W., 15.8 feet, with no marks visible.

And the bearing tree by Herzstein in 1981:

- 18" diam. incense cedar, bears S. 32° W., 74.3 feet, (record S. 32° E.) with a healed double blaze.


**Description of monument and accessories I established to perpetuate the original location of this corner:**

No new measurements were taken for this corner renewal. This report is only to report the wrong quadrant for the 1981 bearing tree.

Leonard E. Herzstein, L.S. 2150  
Umpqua National Forest  
2900 NW Stewart Parkway  
Roseburg, OR 97471

My certificate expires June 30, 2011

**FILED**  
Date: 3-17-2011 By: JC  
This survey consists of:  
Map: \_\_\_\_\_  
Narrative: \_\_\_\_\_  
Corner Fpt: CS 65/72-7

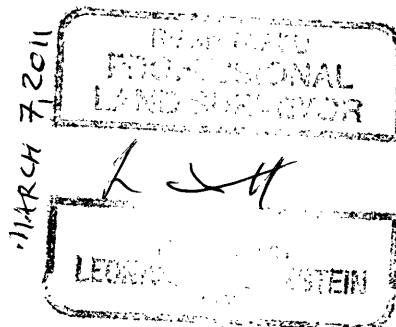

**C.S. File No** 65/72-7

**DOUGLAS COUNTY  
SURVEYOR**