

FILED

Date: 7/21/2011 By: JC

This survey consists of:

Map: _____

Narrative: _____

Corner Rpt: CS 65/72-29

OREGON CORNER RESTORATION FORM

Section 34 Township 29 S Range 6 W

County Douglas Date July 14, 2011

DOUGLAS COUNTY
SURVEYOR

Corner Designation

Corner common to Sections
27, 28, 33 and 34

- Condition Report Only
- Not Found
- Renewed
- Unrecorded
- Surveyed In
- Referenced Out

Previous Renewals/Surveys, etc.

Original: W.H. Byars in 1871. Renewed in 1924 by J.W. Cole.

1958 B.L.M. resurvey by Thielsen and White.

Monument(s) & Accessories Found: (Condition and Source)


1958 B.T.: A 28" diam. Fir high stump with bark scribing visible
bears N.26°W, 83 links (54.8 feet).

1924 renewal: Face of boulder bears S.24°E, 9.9 feet. (No markings found).

All other bearing trees are gone.

Monument Detail

Sketch

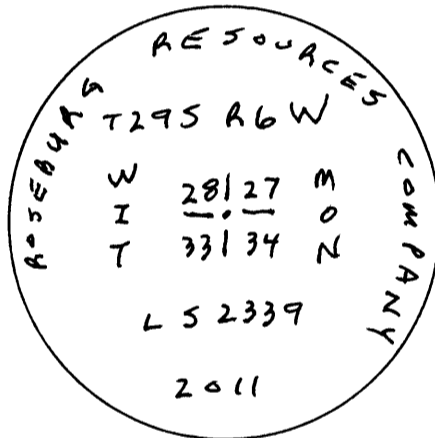

Monument Set (Procedures and Description)

Set a 5/8" x 30" steel rebar 26" in the ground with 2 1/2" diam. alum. cap.

The true corner position falls in a creek bed which has widened out since the
1958 survey. No trace of mound of stones could be found. I set a witness
monument on the NE'ly high bank 10.53' North of the true corner position.

New Accessories

A 9" diam. Fir scribed "WM BT" bears N.13°E., 29.8 feet.

A 7" diam. Fir scribed "WM BT" bears N.71°E., 29.5 feet.


No other trees available.

A 6 foot steel post is set 1.4' North. A steel "tee" post
at the South end of a down wire fence is at the wit. mon.

Location & Comments

Surveyor's Seal

True corner falls in Compass Declination 18°
small creek, bearing Firm/Agency David Edwards
northwesterly. Land Surveying
Recent (10 years or so) Address P.O. Box 361
clearcuts to NW and SW. Oakland, OR. 97462
Party Chief David Edwards
Notes David Edwards
Witness Brant Miller

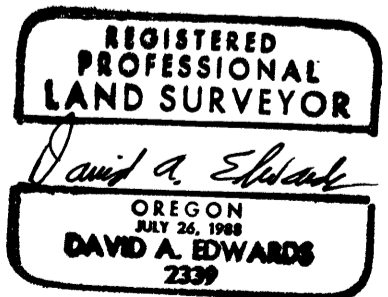

C.S. File No 65/72-29