

CORNER REPORT FORM

Section 18 Township 30S Range 7W
Douglas County **Date:** June 2010
CORNER DESIGNATION: E1/16 Sec 18 / 19

- Condition Report only
- Not Found
- Renewed
- Unrecorded
- Surveyed In
- Referenced out


Previous Renewals/Surveys, etc:

Dependant Resurvey - Albright & Bowder -
July & August 1972, Page 14894
Dependant Resurvey - Bedell - April & May 1987,
Page 18395

Monument(s) & Accessories Found: (Condition and Source)

9" fir, N 61 E, 8.25', tree sheared off approximately 2' above ground and laying on ground. 1972
14" fir, S 45 W, 24.42', uprooted and rotting on ground. 1972

Monument Detail Sketch:

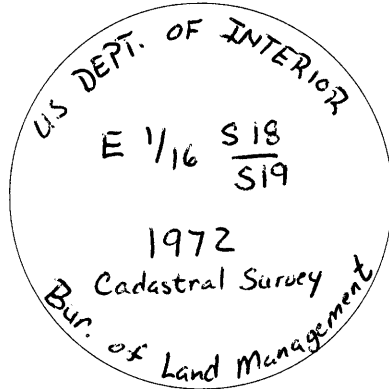

FILED

Date: 10-7-2011 By: JC
This survey consists of:
Map: _____
Narrative: _____
Corner Rpt: CS 65/72-33

**DOUGLAS COUNTY
SURVEYOR**

Monument Set: (Procedures and Description)

New Accessories:

40" Douglas fir, S 74 E, 36.7' measured to nail in side-center of stump.
Scribed "E1/16BT" with LS 2354 brass washer
35" Douglas fir, N 74 E, 58.1' measured to nail in side-center of stump.
Scribed "E1/16BT" with LS 2354 brass washer

Location & Comments:

Compass Declination: 18°
Firm/Agency: Roseburg Forest Products
Address: PO Box 1088
Roseburg, OR 97470
Party Chief: Niel Danko
Notes:
Witness: Forrest Costales

Surveyor's Seal

REGISTERED
PROFESSIONAL
LAND SURVEYOR

Mark F. Smalley

OREGON
July 26, 1988
MARK F. SMALLEY
2354

RENEWS: 6/30/2012

C.S. File No 65/72-33