

CORNER REPORT FORM

Section 18 Township 23S Range 6W
Douglas County Date 10/18/11

CORNER DESIGNATION

West 1/4 corner Section 18
East 1/4 cor. Sec. 13, T23S, R7W

___ Condition Report only
___ Not Found
 Renewed
___ Unrecorded
___ Surveyed In
___ Referenced out

Previous Renewals/Surveys, etc:

GLO original W.H. Byars in 1881; BLM resurvey in 1957.

Monument(s) & Accessories Found: (Condition and Source)

Found 1957 BLM brass cap projecting 2" above ground. The cap is oriented 180° from normal.

20" Fir capped stump bears S. 39 1/2° W., 28.4 feet. Scribing visible.

Fir to SE completely missing.

North-South fence around BLM reprod. is 6' West.

FILED

Monument Detail

Sketch

Date: 10-20-2011 By: JC

This survey consists of:

Map: _____

Narrative: _____

Corner Rpt: CS 65/72-34


DOUGLAS COUNTY
SURVEYOR

Monument Set (Procedures and Description)

N/A


New Accessories

An 11" diam. Fir scribed "1/4 S18 BT" bears N. 7° E., 38.2 feet.
An 8" diam. Fir scribed "1/4 S13 BT" bears N. 87° W., 15.2 feet.
Set a 6 foot steel post 2 feet to the North.

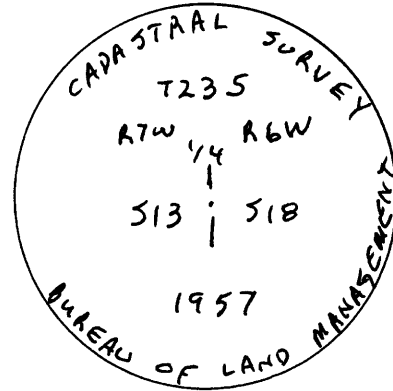

Location & Comments

Surveyor's Seal

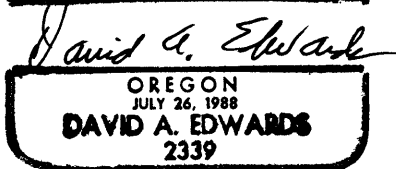

Renews 12/31/11

Compass Declination 17°

Firm/Agency: David Edwards Land Surveying
P.O. Box 361

Address: Oakland, Oregon 97462

Party Chief: David Edwards

Notes:

Witness: Brant Miller

C.S. File No 65/72-34