

RECORD OF SURVEY  
FOR: SENECA JONES TIMBER COMPANY  
NW1/4, SW1/4, SECTION 20, T28S, R4W, W.M.  
DOUGLAS COUNTY, OREGON  
14 JANUARY 2011




FILED

Date: 1-19-2011 By: *RLR*  
This survey consists of:  
Map: *CS 65/74-2*  
Narrative: \_\_\_\_\_  
Corner Rpt: \_\_\_\_\_




DOUGLAS COUNTY  
SURVEYOR

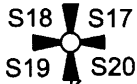

SECTION CORNER SECTIONS 17-18-19-20  
FOUND 1958 BLM BRASS CAP WITH THE FOLLOWING ACCESSORIES:  
13" X 5' D. FIR STAUB BEARS N 34-1/2° E 4.6' - SCRIBING VISIBLE  
RECORD 23" FIR S 56-1/4° E 9.9' DOWN  
16" D. FIR BEARS S 13° W 9.6' - HEALED FACE WITH BARK SCRIBING  
35" D. FIR SNAG BEARS N 41° W 12.0' - NO MARKS  
RECORD 18" FIR N 87° E 8.4' - DOWN  
20" D. FIR BEARS S 88-1/2° W 8.3' - SCRIBING VISIBLE

LEGEND

- FOUND SURVEY MONUMENT AS NOTED
- FOUND 1/4 CORNER AS NOTED
- FOUND SECTION CORNER AS NOTED
- POSTED LINE AS NOTED
- RECORD DATA SURVEY FILE M124-53

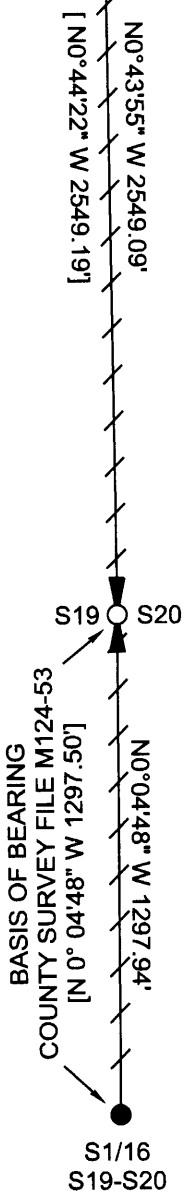

1/4 CORNER SECTIONS 19-20  
FOUND 1961 DOUGLAS COUNTY BRASS CAP WITH THE FOLLOWING ACCESSORIES:  
36" D. FIR STUMP BEARS N 20° W 27.7' - BARK SCRIBE VISIBLE  
RECORD 10" FIR N 16° E 35.0' - ROTTED DOWN  
24" I. CEDAR BEARS S 28° W 10.0' - HEALED FACE  
17" I. CEDAR BEARS N 65° E 15.3' - HEALED FACE

NARRATIVE:  
THE PURPOSE OF THIS SURVEY WAS TO MARK THE LINES SHOWN ON THIS RECORD OF SURVEY WITH RED PAINTED BLAZES, RED FLAGGING AND GALVANIZED STEEL POST AT 200 FT. INTERVALS +/-.  
A TRAVERSE WAS RUN BETWEEN EXISTING CORNERS FOR CONTROL, USING COUNTY SURVEY M124-53 AS THE BASIS OF BEARING.  
THIS SURVEY WAS PERFORMED USING A NIKON TOTAL STATION.

S1/16 SECTIONS 19-20  
FOUND 1997 ALUMINUM CAP PER M124-53 WITH THE FOLLOWING ACCESSORIES:  
23" D. FIR BEARS N 1° W (RECORD N 5° E) 35.2' - HEALED FACE  
23" I. CEDAR BEARS S 34° E 18.0' - SCRIBING VISIBLE

REGISTERED  
PROFESSIONAL  
LAND SURVEYOR

*Ronald L. Rice*

OREGON  
JULY 9, 2002  
RONALD L. RICE  
54633LS

EXPIRATION DATE: 12-31-2012



Ward NorthWest, Inc.

P.O. BOX 105 FLORENCE, OR 97439  
(541) 997-9201 FAX: 541-997-3546

FILE NAME		
10-67.TRV		
SCALE	DATE	DRAWN BY
500 Ft/in	1-14-11	RLR
JOB	REVISION	SHEET
FROZEN WEST	----	1/1

This map drawn with TRAVERSE PC Software