

**RECORD OF SURVEY**

FOR: SENECA JONES TIMBER COMPANY  
 N 1/2, SECTION 20, T31S, R4W, W.M.  
 DOUGLAS COUNTY, OREGON  
 7/31/2011


SECTION CORNER S18/S17/S20/S19  
 FND: 1976 DCBC WITH THE FOLLOWING  
 ACCESSORIES;

- 42" D. FIR BEARS N 63° E, 24.1' (HEALED FACE)
- 18" HEMLOCK BEARS S 46° E, 9.6' (HEALED FACE)
- 34" D. FIR BEARS N 48° W, 62.6' (HEALED FACE)
- 14" HEMLOCK BEARS S 41° W, 14.7' TO SPIKE IN FACE (VISIBLE "X")

1/4 CORNER S 17/S 20  
 FND: 7/8" IRON PIPE, SET BY BLM PER M81-17  
 WITH THE FOLLOWING ACCESSORIES;  
 12" MADRONE BEARS N 87° W, 8.3' WITH BLM BT TAG, NO MARKS  
 21" D. FIR ROTTED STAUB BEARS N 22-1/2° W, 16.7' WITH BLM TAG. NO MARKS  
 14" MADRONE BEARS S 38° E, 38.3' (HEALED BARK SCRIBE)  
 NEW BT  
 9" D. FIR BEARS N 9° W 21.9' BLAZED, SCRIBED "1/4 S17 BT"

FILED  
 DATE 8-10-2011 BY: JC  
 This survey consists of:  
 Map: CS 65/74-11  
 Narrative: \_\_\_\_\_  
 Corner Rpt: \_\_\_\_\_

DOUGLAS COUNTY  
 SURVEYOR

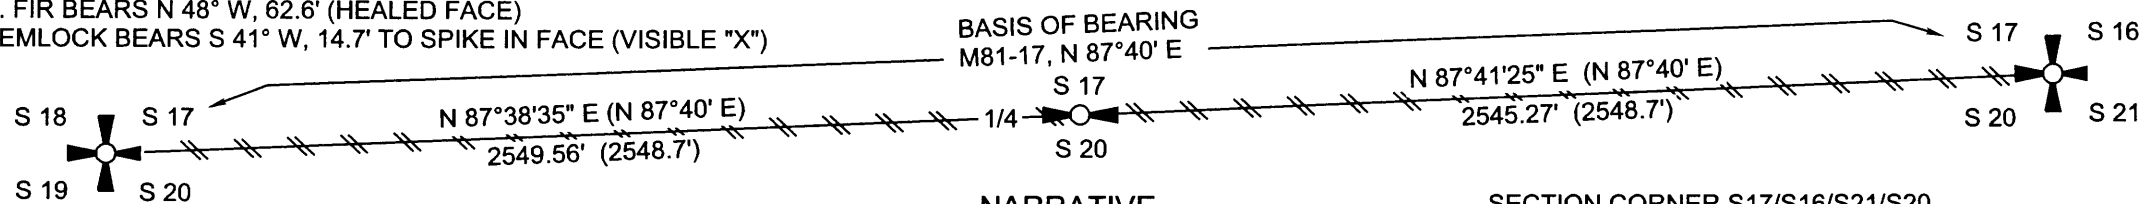

**NARRATIVE**

THE PURPOSE OF THIS SURVEY WAS TO BLAZE AND POST THE NORTH BOUNDARY OF SECTION 20, AS SHOWN HEREON. ALL CORNERS SHOWN AS FOUND WERE HELD AS CONTROL.  
 THE BASIS OF BEARING FOR THIS SURVEY IS AS SHOWN HEREON. THIS SURVEY WAS PERFORMED USING A NIKON TOTAL STATION.

SECTION CORNER S17/S16/S21/S20  
 FND: 2-1/2" DCBC DATED 1966 WITH THE FOLLOWING ACCESSORIES;  
 37" D. FIR BEARS S 71-1/2° E, 15.5' (HEALED FACE)  
 23" HEMLOCK BEARS S 66 1/2° W, 11.3' (HEALED FACE)  
 20" D. FIR BEARS N 68° W, 20.5' (HEALED FACE)  
 8" HEMLOCK BEARS N 57° E, 32.8' (VISIBLE SCRIBING)

**LEGEND**

- FND: 1/4 CORNER AS NOTED HEREON
- FND: SECTION CORNER AS NOTED HEREON
- LINE BLAZED, PAINTED WITH RED PAINT AND POSTED WITH 5-1/2 FOOT GALVANIZED STEEL POSTS SET AT AN INTERVAL NOT TO EXCEED 200 FEET
- DCBC DOUGLAS COUNTY BRASS CAP
- CS COUNTY SURVEYOR
- ( ) RECORD DATA PER M81-17

REGISTERED  
 PROFESSIONAL  
 LAND SURVEYOR

OREGON  
 ROBERT B. WARD JR.  
 JULY 30, 1976  
 LS 1091

RENEWAL DATE: 6/30/2012

**Ward NorthWest, Inc.**  
 Land Surveying & Planning  
 1732 Laurel PL. Suite A  
 Florence, OR 97439  
 541-997-9201

