



RECORD OF SURVEY  
 FOR: SENECA JONES TIMBER COMPANY  
 NW1/4, SECTION 6, T. 32 S., R. 3 W., W.M.  
 DOUGLAS COUNTY, OREGON  
 1 SEPTEMBER 2011

FILED  
 DATE 9-7-2011 BY: RLR  
 This survey consists of:  
 Map: CS 65/74-17  
 Narrative: \_\_\_\_\_  
 Corner Rpt: \_\_\_\_\_

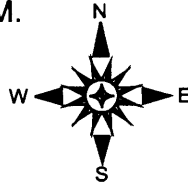

DOUGLAS COUNTY  
 SURVEYOR

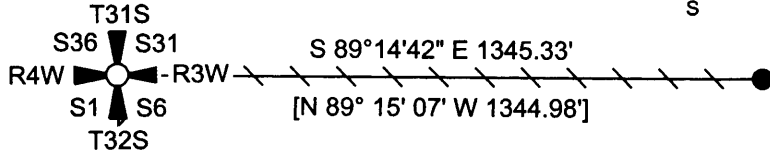

SECTION CORNER SECTIONS 1, 6, 31, 36  
 FOUND DOUGLAS COUNTY BRASS CAP DATED 1966  
 WITH THE FOLLOWING ACCESSORIES:  
 20" HEMLOCK STUMP BEARS S 33-1/4° W 185.5' - SCRIBING VISIBLE  
 24" FIR STUMP BEARS N 12° W 142.0' - ROTTED FACE  
 28" D. FIR BEARS N 2° E 120.3' - HEALED FACE  
 OTHER ACCESSORIES OF RECORD NOT FOUND  
 NEW BT 9" W. FIR BEARS S 86-3/4° E 140.2' - SCRIBED "T32S R3W S6 BT"

1/4 CORNER SECTIONS 1,6  
 FOUND 1/12" O.D. IRON PIPE (RECORD 2")  
 WITH THE FOLLOWING ACCESSORIES: E  
 21" FIR STUMP BEARS N 68° W 5.3' - ROTTED FACE  
 24" FIR ROTTED STAUB BEARS N 48° W 12.0' - NO MARKS  
 16" FIR BEARS S61-3/4° W 14.5' - HEALED FACE  
 NEW BT 18" D. FIR BEARS S 18° E 16.5' - SCRIBED "1/4 S6 BT"

W1/16 CORNER SECTIONS 6, 31  
 FOUND 5/8" REBAR WITH YELLOW PLASTIC CAP "R. BROWN PLS 2391"  
 WITH THE FOLLOWING ACCESSORIES:  
 11" I. CEDAR SNAG BEARS N 73° E 22.7' (RECORD 23.1') INCORRECTLY  
 SCRIBED "CW1/16 BT"  
 5" D. FIR BEARS N 59° W 15.0' (RECORD 14.6') INCORRECTLY SCRIBED  
 "CW1/16 BT"

BASIS OF BEARING COUNTY SURVEY FILE M157-10  
 N 0°56'25" W 2621.14' [N 0° 56'25" W 2621.101]

LEGEND

- FOUND 1/16 CORNER AS NOTED
- FOUND 1/4 CORNER AS NOTED
- FOUND SECTION CORNER AS NOTED
- POSTED LINE, MARKED WITH RED PAINTED BLAZES  
RED FLAGGING AND 5-1/2' GAL. STEEL POSTS  
SET AT 200' +/- INTERVALS
- [ ] RECORD DATA COUNTY SURVEY FILE M157-10

NARRATIVE:  
 THE PURPOSE OF THIS SURVEY WAS TO MARK THE LINES SHOWN HEREON AS  
 POSTED IN THE MANNER DESCRIBED IN THE LEGEND.  
 CONTROLLING CORNERS WERE TIED BY TRAVERSE AND HELD IN THEIR AS TIED  
 POSITION FOR THE POSTING OF TRUE LINE.  
 BASIS OF BEARING FOR THIS SURVEY WAS THE COUNTY SURVEY FILE M157-10.  
 THIS SURVEY WAS PERFORMED USING A NIKON TOTAL STATION.



REGISTERED  
 PROFESSIONAL  
 LAND SURVEYOR

*Ronald L. Rice*

OREGON  
 JULY 9, 2002  
 RONALD L. RICE  
 54633LS

EXPIRATION DATE: 12-31-2012

FILE NAME		
11-33.TRV		
SCALE	DATE	DRAWN BY
400 Ft/in	9-1-2011	RLR
JOB	REVISION	SHEET
SNOW CK.	---	1/1

This map drawn with TRAVERSE PC Software