

FILED

Date: 2-8-2012 By: JC

This survey consists of:

Map: \_\_\_\_\_

Narrative: \_\_\_\_\_

Corner pts: CS 65/76-10

## ***CORNER NOTES***

DECEMBER 2011

BY: TONY HOSTETTER  
63538 PINTAIL DR.  
COOS BAY, OR 97420

DOUGLAS COUNTY  
SURVEYOR

FOR: WEYERHAEUSER COMPANY  
98674 DELLWOOD LANE  
COOS BAY, OR 97420

***CC SECTION 28 AND SECTION 33, T.23 S., R.9 W., W.M.***  
DOUGLAS COUNTY, OREGON

FOUND: 1977 BLM BRASS CAP AND BOTH BTS AS DESCRIBED ON PAGE  
16221 DOUGLAS COUNTY RECORDS.


FROM WHICH:

1973 DOUGLAS COUNTY SURVEYOR BRASS CAP  
BEARS; S88°04'E, 4.59 FEET.

NEW BTS:

20" FIR, SCRIBED "S28 SW BT", WEYCO TAG,  
BEARS; N 61°13'E, 25.2 FEET TO SPIKE IN ROOT COLLAR.

NW CC 33-23-9.DOX

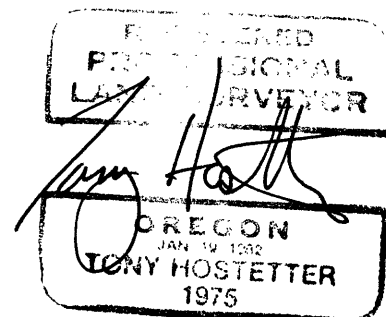

EXPIRES: 6/30/13

C.S. File No 65/76-10