

CORNER REPORT FORM

Section 35 Township 29S Range 3W  
Douglas County Date 2-2012

CORNER DESIGNATION

504700 T 30 S R 3W  
500100 T 29 S R 3W

Condition Report only  
Not Found  
Renewed  
Unrecorded  
Surveyed In  
Referenced out

Previous Renewals/Surveys, etc:

DC 50 1960  
M 17-51 - M 145-76 - M 66-6

Monument(s) & Accessories Found: (Condition and Source)

Fd D&S BRASS CAP  
A 42" fir STUMP N35W 46.2 FT Healed FACE  
A 26" MADRONA N81E 20.4 FT. NO MARKS  
A 16" fir N30E 15.7' GOOD SCAR  
A 12" fir N56W 617 FT GOOD SCAR

Monument Detail

Sketch

DOUGLAS COUNTY SURVEYOR OFFICE  
BRASS CAP 12" ABOVE GROUND.

FILED  
Date: 2/24/2012 By: JC  
This survey consists of:  
Map: \_\_\_\_\_  
Narrative: \_\_\_\_\_  
Corner Rpt: CS 65/76-22

DOUGLAS COUNTY  
SURVEYOR

Monument Set (Procedures and Description)

New Accessories

A 14" MADRONA <sup>BACK</sup> scribed 534 BT BEARS N10°W  
34.1 Feet.

Location & Comments

CORNER IS IN  
S.E. CORNER OF  
CLEAR CUT UNIT  
ON SOUTH SLOPE  
APPROX 250' SOUTH  
OF ROAD.

Compass Declination

Firm/Agency: i.e. Engineering, Inc.


Address: 809 S.E. Pine Street  
Roseburg, OR 97470

Party Chief: R. Quimby

Notes:

Witness:

Surveyor's Seal

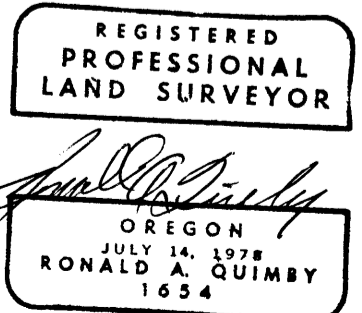

C.S. File No 65/76-22

EXP 12-31-12