

CORNER REPORT FORM

Section 35 Township 30S Range 3W  
Douglas County Date 2/2012

CORNER DESIGNATION

542700 T30S R3W  
540100 T29S R3W

Condition Report only  
Not Found  
Renewed  
Unrecorded  
Surveyed In  
Referenced out

Previous Renewals/Surveys, etc:

DCSO 1960 M86-6

Monument(s) & Accessories Found: (Condition and Source)

DCSO BRASS CAP IN GOOD CONDITION  
14" D. FIR STUMP 6' HIGH WITH GOOD SCRE  
N44°E 15° FT

Monument Detail

Sketch

DCSO BRASS CAP ON T.I.P.  
10" ABOVE GROUND ALONG SIDE  
16" D. FIR STUMP

FILED

Date: 2/24/2012 By: SC

This survey consists of:

Map: \_\_\_\_\_

Narrative: \_\_\_\_\_

Corner Rpt: CS 65/76-24

DOUGLAS COUNTY  
SURVEYOR

Monument Set (Procedures and Description)

NONE

New Accessories

7" D. FIR NSBE 10.1 FT scribed 1/4 535 BT  
ON SINGLE FACE  
8" D. FIR N90W 20.3 FT scribed 1/4 535 BT  
ON SINGLE FACE  
12" D. FIR N41°W 17° FT scribed 1/4 535 BT  
ON SINGLE FACE  
6" FIR N24E 14.4 FT scribed x @ breast HIGH  
BT @ BASE

Location & Comments

Surveyor's Seal

CORNER IS ON  
A STEEP FACING  
EAST SLOPE  
APPROX 400' EAST  
OF ROAD

Compass Declination



Firm/Agency: i.e. Engineering, Inc.

Address: 809 S.E. Pine Street  
Roseburg, OR 97470

Party Chief: R. Quimby *Ronald A. Quimby*

Notes:

Witness:

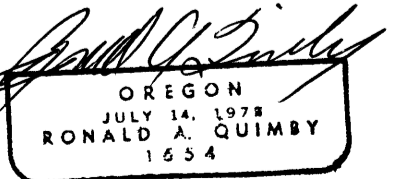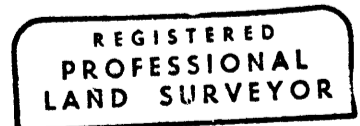

C.S. File No 65/74-24 EXP-12-31-12