

CORNER REPORT FORM

Section 2 Township 30S Range 3W
Douglas County Date 2-12

CORNER DESIGNATION

W $\frac{1}{16}$ $\frac{2}{11}$

Condition Report only
Not Found
Renewed
Unrecorded
Surveyed In
Referenced out

Previous Renewals/Surveys, etc:

M 86-6

Monument(s) & Accessories Found: (Condition and Source)

Fd $\frac{5}{8}$ " I. ROD with Alum CAP
24" fir stump south 7^E FT

FILED

Date: 2/29/2012 By: NW
This survey consists of:

Map: _____

Narrative: _____

Corner Rpt: CS 65/76-28

DOUGLAS COUNTY
SURVEYOR

Monument Detail

Sketch

$\frac{5}{8}$ " I. ROD with Alum CAP

Monument Set (Procedures and Description)

New Accessories

A 11" D. fir BEARS N55E 138 FT
scribed W $\frac{1}{16}$ S2 BT

A 11" D. fir BEARS S15E 18^E FT
scribed W $\frac{1}{16}$ S11 BT

Location & Comments

Surveyor's Seal

Compass Declination


Firm/Agency: i.e. Engineering, Inc.

Address: 809 S.E. Pine Street
Roseburg, OR 97470

Party Chief: Ron Quimby

Notes:

Witness:

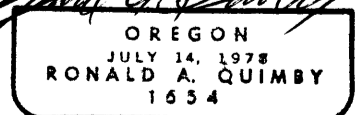

C.S. File No 65/76-28

EXP 12-31-12