

FILED

OREGON CORNER RESTORATION FORM

Date: 4-10-2012 By: J

This survey consists of:

Map: _____

Narrative: _____

Corner Rpt: CS 65/76-37

Section 8 Township 20 South, Range 8 West

County Douglas

Date 9 April 2012

DOUGLAS COUNTY
SURVEYOR

Corner Description

N1/4

___ Condition Report Only

Section 8

___ Not Found

X Renewed

___ Unrecorded

___ Surveyed In

___ Referenced Out

Previous Renewals / Surveys, etc.

Monument (s) & Accessories Found: (Condition and Source)

Found - 2 1/2" BLM brass cap on iron pipe, dated 1954

A fir snag, 23" dia., bears S.54 1/4°W., 47.5 ft., with scribe marks 1/4 S8 BT visible on partially healed blaze.

No change

A burned cedar stump, 31" dia., bears N.59°W., 46.2 ft., no marks visible.

No change

A fir, 16" dia., bears S.17°E., 12.2 ft., mkd. 1/4 S8 BT.

Now 19" with healed face

A fir, 9" dia., bears N.7 1/2°W., 23.0 ft., mkd. 1/4 S5 BT.

Now 9" with healed face

Monument Detail

Sketch

Monument Set (Procedures and Description)

None

New Accessories

23" D. Fir bears N 74° E 12.1 ft. blazed, scribed, 1/4 S5 BT

Location & Comments

Corner has steel post _____ Compass Declination 16° East
adjacent to it. _____ Firm/Agency Ward NorthWest Inc.


All BT's have red painted
bands and yellow tags. _____ Address 1732 Laurel Pl. Ste. A
_____ Florence, OR 97439

_____ Party Chief Ron Rice


_____ Notes _____

_____ Witness Jason Colver

Surveyor's Seal

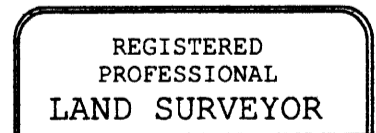

Ronald L. Rice

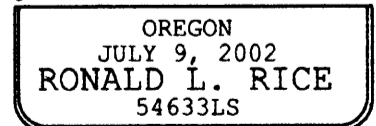

RENEWS: 12-31-2012

C.S. FILE 65/76-37