

CORNER REPORT FORM

Section 34 Township 28S Range 8W
Douglas County Date 4-12

CORNER DESIGNATION

400140

Condition Report only
Not Found
Renewed
Unrecorded
Surveyed In
Referenced out

Previous Renewals/Surveys, etc:

BLM Resurvey 1975

Monument(s) & Accessories Found: (Condition and Source)

Fd BLM BRASS CAP GOOD CONDITION
Fd 24" CEDAR S 38 1/4 E 40 9 FT GOOD SCAR

Monument Detail

Sketch

Fd BLM BRASS CAP

FILED

Date: 4-26-2012 By: J
This survey consists of:
Map: _____
Narrative: _____
Corner Rpt: CS 65/76-39

**DOUGLAS COUNTY
SURVEYOR**

Monument Set (Procedures and Description)

None

New Accessories

A 14" CEDAR N 34W 16 7 FT scribed 1/4 S 33 BT
A 19" D. FIR N 79 0 E 8 8 FT scribed 1/4 S 34 BT
A 11" D. FIR S 50W 24 3 FT scribed 1/4 S 33 BT

Location & Comments

Surveyor's Seal

Compass Declination

Firm/Agency: i.e. Engineering, Inc.


Address: 809 SE Pine St.
Roseburg, OR 97470

Party Chief: J. LEONARD

Notes:

Witness: J. LAUB

C.S. File No 65/7639

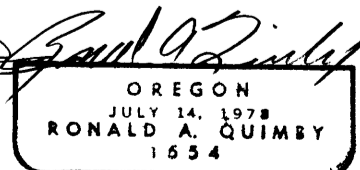

EXP 12-31-12