

CORNER REPORT FORM

Section 34 Township 28S Range 8W
Douglas County Date 4-12

CORNER DESIGNATION

400100

Condition Report only
Not Found
Renewed
Unrecorded
Surveyed In
Referenced out

Previous Renewals/Surveys, etc:

DCSO M-42-67 BLM Resurvey 1975

Monument(s) & Accessories Found: (Condition and Source)

DCSO BRASS CAP

24" D FIR S16W 18³ FT
20" D FIR N22E 27⁷ FT
14" W. FIR S88E 41⁶ FT

Monument Detail

Sketch

FD DCSO BRASS CAP

FILED

Date: 4-26-2012 By: JC
This survey consists of:
Map: _____
Narrative: _____
Corner Rpt: CS 65/76-40

DOUGLAS COUNTY
SURVEYOR

Monument Set (Procedures and Description)

NONE

New Accessories

A 9" D FIR N74E 42° FT scribed T28 RB S33 RT

Location & Comments

Surveyor's Seal

Compass Declination

Firm/Agency: i.e. Engineering, Inc.



Address: 809 SE Pine St.
Roseburg, OR 97470

Party Chief: J. LEONARD

Notes:

Witness: J. LAUB

C.S. File No 65/76-40

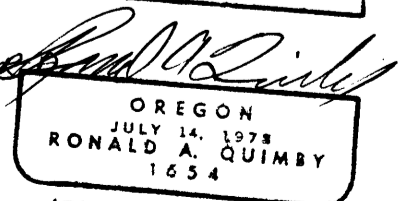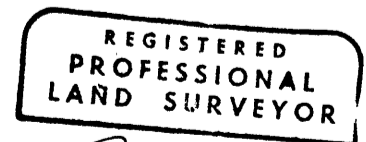

EXP 12-31-12