

CORNER REPORT FORM

Section 34 Township 28S Range 8W
Douglas County Date 4/12

CORNER DESIGNATION 44200

Condition Report only
Not Found
Renewed
Unrecorded
Surveyed In
Referenced out

Previous Renewals/Surveys, etc:

BLM 1975
DCSO 1957

Monument(s) & Accessories Found: (Condition and Source)

DCSO BRASS CAP
Fd. 48" D. FIR N30E 6² FT BARK Scribed
Fd 36" Cedar S59⁰W 40³ Fd GOOD SCAR
Fd 14" MADRONA (slid down hill)

Monument Detail

Sketch

DCSO BRASS CAP

FILED
Date: 4/26/2012 By: SC
This survey consists of:
Map: _____
Narrative: _____
Corner Rpt: CS 65/76-42

DOUGLAS COUNTY
SURVEYOR

Monument Set (Procedures and Description)

None

New Accessories

A 12" MADRONA N60E 28⁶ FT Scribed 1/4 S27 BT
A 48" D. FIR N38W 32³ FT Scribe 1/4 S 27 BT

Location & Comments

Surveyor's Seal

Compass Declination

Firm/Agency: i.e. Engineering, Inc.


Address: 809 SE Pine St.
Roseburg, OR 97470

Party Chief: J. LEONARD

Notes:

Witness: J LAUB

C.S. File No 65/76-42

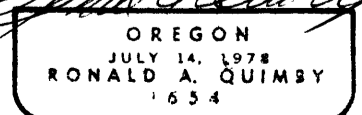

EXP 12-31-12