

LANE COUNTY SURVEYORS OFFICE  
DEPARTMENT OF PUBLIC WORKS

FILE NO 24-15-35 SE ONLY

TRGCDB 2415600100

INDEX NO 14971

**CORNER REPORT**

THE SECTION CORNER COMMON TO SECTIONS 35 AND 36 ONLY, T24S, R1E, W M

DATE	1898	1928	1979
SURVEYOR	A GESNER	J COLLINS	D GAYLORD
SOURCE	GLO VOL. R-411	GLO VOL. R-535	RE 7918 & DOUG CO RENEWAL
MONUMENT FOUND		6" x 10" BASALT STONE, 6" ABOVE GRADE, WITH RECORD NOTCHES	5" x 9" x 14" LOOSE STONE WITH PROPER MARKS
MONUMENT SET	5" x 10" x 12" BASALT STONE, 5 NOTCHES ON WEST SIDE, 1 ON EAST	RE-MARK STONE "S36" ON NE FACE, "S35" ON NW TO CHANGE STONE TO REFER TO SEC 'S 35 AND 36 ONLY	1-1/2" x 36" IRON PIPE WITH 2-1/2" BRASS CAP, BURY STONE ALONGSIDE
BEARING OBJECT 1	10" FIR "T24S R1E S36 BT" N46°40'E @ 25 LKS = 16 5'	HAS BEEN BURNED	NO REMAINS
BEARING OBJECT 2	10" FIR "T25S R1E S1 BT" S54°30'E @ 30 LKS = 19 8'	HAS BEEN BURNED	NO REMAINS
BEARING OBJECT 3	10" FIR "T25S R1E S2 BT" S79°W @ 59 LKS = 38 9'	HAS BEEN BURNED	NO REMAINS
BEARING OBJECT 4	<b>20" FIR "T24S R1E S35 BT" N22°30'W @ 110 LKS = 72 6'</b>	30" FIR @ RECORD	38" D FIR WITH HEALED FACE N23°30'W @ 72 6'
BEARING OBJECT 5		<b>8" FIR "T24S R1E S36 BT" N73°E @ 163 LKS = 107 6'</b>	24" D FIR WITH HEALED FACE N74°E @ 107 6'
BEARING OBJECT 6		<b>SET 2" x 36" IRON POST W/ BRASS CAP, SEC 'S 1 &amp; 2, S89°02'W @ 0 86 CHS = 56 8'</b>	CORNER BRS S89°30'W @ 57 3'
BEARING OBJECT 7			<b>15" D FIR "T24S R1E S36 BT" N25°30'E @ 56 8'</b>

**BOLDED ENTRIES** IN THE ABOVE TABLE CORRESPOND WITH FOUND OBJECTS DESCRIBED IN "EVIDENCE RECOVERED" SHOWN BELOW. THOSE ENTRIES NOT BOLDED WERE NOT FOUND.

**CORNER EVIDENCE****EVIDENCE RECOVERED**

AT THE CORNER POSITION FOUND A 2-1/2" BRASS CAP DATED 1979 ATOP A 1" IRON PIPE IN STONE MOUND

1898 [4] A 43" D FIR WITH HEALED FACE BRS N23°36'W @ 71 8' ( N22°30'W @ 72 6' )

1928 [5] A 24" x 30" TALL ROTTEN D FIR SNAG WITH HEALED FACE BRS N73°07'E @ 106 8' ( N73°E @ 107 6' )

1928 [6] A 2-1/2" BRASS CAP DATED 1928 (25-15-01 NW C C ) BRS S89°12'20"W @ 57 42 ( S89°02'W @ 56 8' )

1979 [7] A 22" D FIR WITH HEALED FACE BRS N25°00'E @ 56 3' ( N25°30'E @ 56 8' )

**MONUMENT SET** NOTHING NEEDED, ACCEPTED THE FOUND BRASS CAP AS MARKING THE CORNER POSITION

**ACCESSORIES ESTABLISHED**

2007 [8] SET A 2" ALUM CAP "LCSO-RP1-2007" ATOP A 5/8" x 30" REBAR BRS S11°04'W @ 22 49'

**NOTES AND OTHER INFORMATION**

**GEOGRAPHIC MAP LOCATION** USE FOR NAVIGATING TO CORNER AREA – NOT OF SURVEY GRADE ACCURACY

LATITUDE – N 43°26'17.4" LONGITUDE – W 122°38'31.9" NAD 83/91 VALUES

**BASIS OF BEARING** TRUE BEARINGS BASED ON GPS OBSERVATIONS

**EQUIPMENT USED** WILD TC-1010 TOTAL STATION & HP-48 GX DATA COLLECTOR

**BEARING TREES.** DISTANCES SHOWN ARE TO CENTER UNLESS OTHERWISE NOTED

DATE SEPTEMBER 17, 2007

BY BRUCE BOTHEL, P L S. ASSOCIATE SURVEYOR **BB**  
JOHN RANDALL, ENGINEERING TECH I **JR**

LANE COUNTY SURVEYORS OFFICE  
DEPARTMENT OF PUBLIC WORKS

FILE NO. 24-15-35 SE ONLY  
TRGCDB 2415600100  
INDEX NO. 14971

1898 [4]  
43" FIR

1979 [7]  
22" FIR

TIMBER

REGISTERED  
PROFESSIONAL  
LAND SURVEYOR

*[Signature]*  
OREGON  
JANUARY 29 1991  
D MICHAEL JACKSON  
2481

RENEWAL DATE 6/30/09

1928 [5]  
24" FIR SNAG


S89°12'20"W @ 57.42'

N73°07'E @ 106.8'

1928 [6]  
BRASS CAP  
25-15-01 NW CC

150'

S11°04'W @ 22.49'

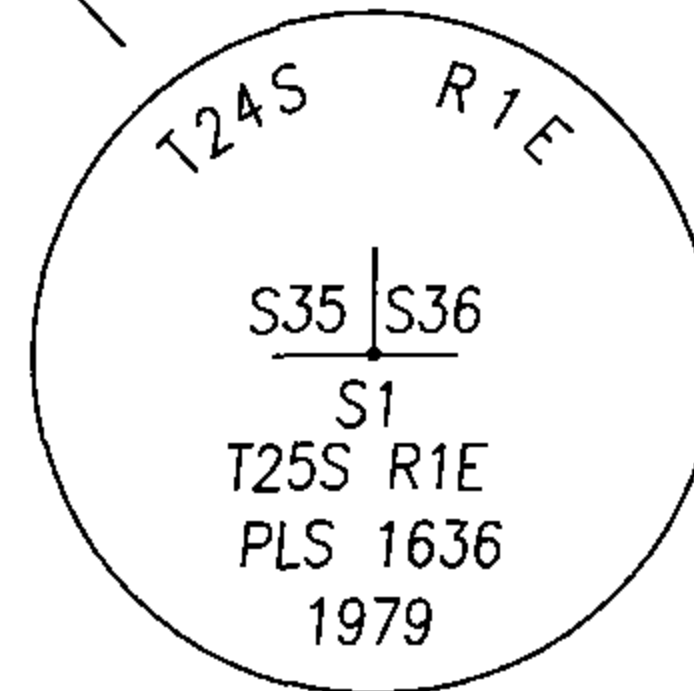

FOUND BRASS CAP

FS RD 3815

2007 [8]  
SET 5/8" IR  
W/ 2" ALUM CAP  
"RP1"



NO SCALE