

OREGON CORNER RESTORATION FORM

Section 1 Township 20 South, Range 9 West  
County Douglas Date 1 May 2012

FILED  
Date: 5/2/2012 By: JC  
This survey consists of:  
Map: \_\_\_\_\_  
Narrative: \_\_\_\_\_  
Corner Rpt: CS 65/76-48

DOUGLAS COUNTY  
SURVEYOR

Corner Description

NW Corner  
Section 1

- Condition Report Only
- Not Found
- Renewed
- Unrecorded
- Surveyed In
- Referenced Out

Previous Renewals / Surveys, etc.

Monument (s) & Accessories Found: (Condition and Source)

Found 2-1/2" GLO. brass cap on iron pipe, dated 1953

- A down Fir 35" dia., bears S.25°E., 70 lks. dist. mkd. T20S R9W S1 BT.  
(Found down Fir, No marks)
- An Alder 13" dia., bears S.60°W., 28 lks. dist., mkd. T20S R9W S2 BT.  
(Missing)
- A Fir 30" dia., bears S.59°E., 30 lks. dist. mkd. T20S R9W S1 BT.  
(Found 30" Fir stump, No marks)

Monument Detail

Sketch

Monument Set (Procedures and Description)

None


New Accessories

- 17" D. Fir bears S 81° W 8.0 ft. blazed, scribed, T20S R9W S2 BT
- 13" D. Fir bears S 79° E 14.2 ft. blazed, scribed, T20S R9W S1 BT

Location & Comments

Corner has steel post \_\_\_\_\_ Compass Declination 16° East  
adjacent to it. \_\_\_\_\_ Firm/Agency Northwest Land  
All BT's have red painted \_\_\_\_\_ Surveying Inc.  
bands and yellow tags. \_\_\_\_\_ Address P.O. Box 2827  
 \_\_\_\_\_ Florence, OR 97439  
 \_\_\_\_\_ Party Chief Ron Rice  
 \_\_\_\_\_ Notes \_\_\_\_\_  
 \_\_\_\_\_ Witness Jason Collver

Surveyor's Seal

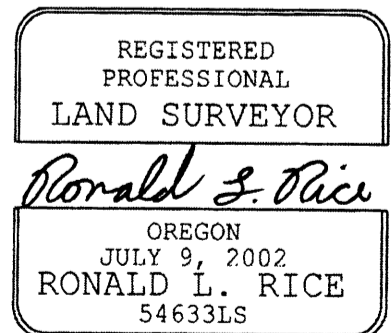

RENEWALS: 12-31-2012

C.S. File No 65/76-48