

OREGON CORNER RESTORATION FORM

FILED
Date: 5/2/2012 By: JK
This survey consists of:
Map: _____
Narrative: _____
Corner Rpt: CS 65/76-49

Section 36 Township 19 South, Range 9 West
County Douglas Date 1 May 2012

DOUGLAS COUNTY
SURVEYOR

Corner Description

N 1/4
Section 36

- Condition Report Only
- Not Found
- Renewed
- Unrecorded
- Surveyed In
- Referenced Out

Previous Renewals / Surveys, etc.

Monument (s) & Accessories Found: (Condition and Source)

Found 3-1/4" BLM brass cap on iron pipe, dated 1958
An Alder, 22" dia., bears N.50-3/4°W., 79 lks., mkd: 1/4 S25 BT.
(Missing)
A Maple, 20" dia., bears S.67°E., 16 lks., mkd: 1/4 S36 BT.
(Missing)

Monument Detail

Sketch

Monument Set (Procedures and Description)

None


New Accessories

18" D. Fir bears N 54° W 18.1 ft. blazed, scribed, 1/4 S25 BT
11" D. Fir bears N 11° E 25.8 ft. blazed, scribed, 1/4 S25 BT
11" D. Fir bears N 83° E 39.2 ft. blazed, scribed, 1/4 S25 BT
14" Red Cedar bears S 30° W 20.0 ft. blazed, scribed, 1/4 S36 BT

Location & Comments

Corner has steel post Compass Declination 16° East
adjacent to it. Firm/Agency Northwest Land
All BT's have red painted Surveying Inc.
bands and yellow tags. Address P.O. Box 2827
_____ Florence, OR 97439
_____ Party Chief Ron Rice
_____ Notes _____
_____ Witness Jason Collver

Surveyor's Seal

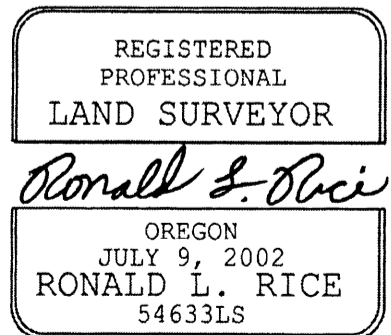

RENEWS: 12-31-2012

C.S. File No 65/76-49