

CORNER REPORT FORM

Section 36 Township 24 S Range 3 W
Douglas County Date June 1, 2012

CORNER DESIGNATION

NE corner of Section 36.

- Condition Report only
- Not Found
- Renewed
- Unrecorded
- Surveyed In
- Referenced out

Previous Renewals/Surveys, etc:

G.L.O. survey by W.H. Byars in 1871.
B.L.M. resurvey in 1951.

Monument(s) & Accessories Found: (Condition and Source)


1951 B.L.M. brass capped iron pipe in mound of stones.
35" diam. Fir stump bears N.82°E., 47.5 feet.
34" diam. Fir stump bears S.26 1/2°E., 94.4 feet.
The fir N.41 1/4°W., 15.2 feet is a windfall.

FILED
Date: 6/5/2012 By JC
This survey consists of:
Map: _____
Narrative: _____
Corner Ref. CS 65/76-59

DOUGLAS COUNTY
SURVEYOR

Monument Detail

Sketch

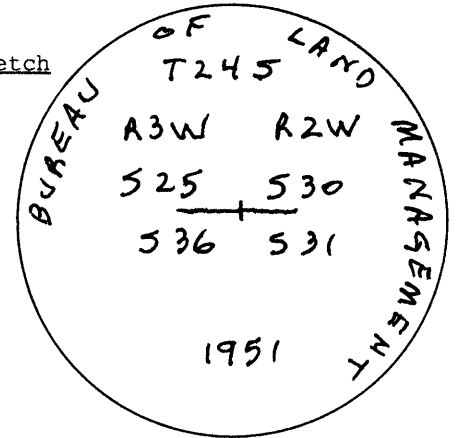

Monument Set (Procedures and Description)

N/A

New Accessories

A 9" diam. Fir bears N.37°E., 14.5 feet. Scribed "T24S R2W S30 BT".
An 8" diam. Hemlock bears S.82°E., 22.9 feet. Scribed "T24S R2W S31 BT".
An 11" diam. Cedar bears South 25°W., 9.5 feet. Scribed "T24S R3W S36 BT".
A 6 foot steel post is set 2 feet West.

Location & Comments

David Edwards Land Surveying
P.O. Box 361
Oakland, Oregon 97462

Compass Declination 180

Firm/Agency:


Address:

Party Chief: Brant Miller

Notes:

Witness: Eric Sprinkle

Surveyor's Seal

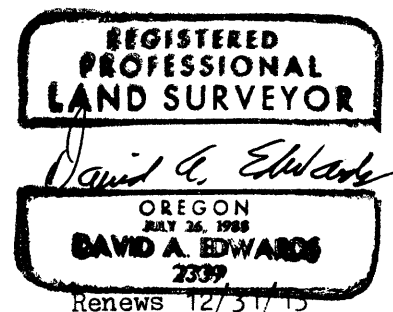

C.S. File No 65/76-59