

CORNER REPORT FORM

Section 12 Township 30 S Range 9 W  
Douglas County Date June 8, 2012

CORNER DESIGNATION

Center-North 1/16 corner  
per M 142-69

- Condition Report only
- Not Found
- Renewed
- Unrecorded
- Surveyed In
- Referenced out

Previous Renewals/Surveys, etc:

Established on M 142-69

Monument(s) & Accessories Found: (Condition and Source)

Aluminum Cap on 5/8" diam. rebar. Cap marked as per M 142-69.

A 10" diam., 6' tall Fir high stump with BT tag and partially healed face bears S.67°E., 17.0 feet.

A 15" diam., 5' tall Fir high stump with BT tag and partially healed face bears S.5°E., 15.4 feet.

Monument Detail

Sketch

N/A SEE ABOVE.

FILED

Date: 6/12/2012 By: JC  
 This survey consists of: \_\_\_\_\_  
 Map: \_\_\_\_\_  
 Narrative: \_\_\_\_\_  
 Corner Rpt: CS65/77-6

DOUGLAS COUNTY  
SURVEYOR

Monument Set (Procedures and Description)

N/A

New Accessories

Set a 5/8" x 30" steel rebar with red plastic cap mkd. "D.A. Edwards-LS 2339" S.35°E., 32.06 feet with a 6 foot steel post set 0.5 feet N.35°W. from rebar.

Set a 5/8" x 30" steel rebar with red plastic cap mkd. "D.A. Edwards-LS 2339" S.68°W., 86.13 feet with a 6 foot steel post set 0.5 feet N.68°E from rebar.

Both posts above have BT tags attached.

A 6 foot steel post is also set 2.0 feet South from the CN 1/16 cor. monument.

Location & Comments

Surveyor's Seal

David Edwards Land Surveying  
P.O. Box 361  
Oakland, Oregon 97462  
541-459-0512

Compass Declination 17°

Firm/Agency:


Address:

Party Chief: David Edwards


Notes:

Witness: Brant Miller

Corner lies in a recent clearcut.

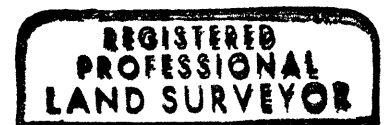

*David A. Edwards*

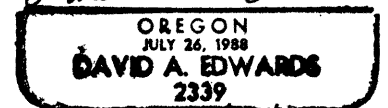

Renews 12/31/13

C.S. File No 65/77-6