

CORNER REPORT FORM

Section 14 Township 3/S Range 4W
Douglas County Date 7-2012

CORNER DESIGNATION

600440
1/4 COR 13-14

Condition Report only
Not Found
Renewed
Unrecorded
Surveyed In
Referenced out

Previous Renewals/Surveys, etc:

MNR/KAM 1958 CS File 42/391

Monument(s) & Accessories Found: (Condition and Source)

Fd 3/4" I. Pipe & Stone
Fd 24" D. FIR Stump N21°E 32.3 FT with TIN CAP
Fd DOWN Cedar Burnt out face

Monument Detail

Sketch

FILED
Date: 7/30/2012 by SC
This survey consists of:
Map: _____
Narrative: _____
Corner Pts: CS 65/77-11
DOUGLAS COUNTY SURVEYOR

Monument Set (Procedures and Description)


New Accessories

A 6" D. FIR S80°W 18.5 FT scribed 1/4 S14 BT
A 6" D. FIR S84°E 2.2 FT scribed 1/4 S13 BT

Location & Comments

Surveyor's Seal

Compass Declination
Firm/Agency: i.e. Engineering, Inc.
Address: 809 SE Pine St.
Roseburg, OR 97470
Party Chief: B. KUAPP
Notes:
Witness:

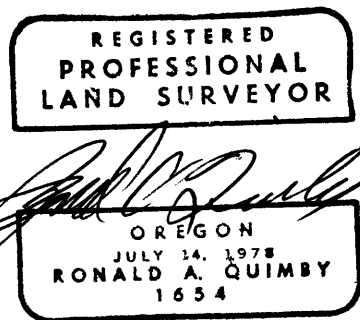

C.S. File No 65/77-11

ETP 12-31-12

✓