

CORNER RESTORATION FORM

FILED

Date: 8/13/2012 By: JC

This survey consists of:

Map: \_\_\_\_\_

Narrative: \_\_\_\_\_

Corner Rpt: CS 65/77-20

DOUGLAS COUNTY  
SURVEYOR

Section 26 Township 30 South, Range 4 West  
County Douglas Date 3 August 2012

Corner Description

S 1/4

Section 26

Condition Report Only

Not Found

Renewed

Unrecorded

Surveyed In

Referenced Out

Previous Renewals / Surveys, etc.

Monument (s) & Accessories Found: (Condition and Source)

2 1/2" brass cap on iron pipe, dated 2006. (Found good condition on 8-3-2012)

A 36" fir stump with healed blaze bears N.5°30'E., 22.4ft to a cotton gin spike set in the center of the stump. (Found same condition on 8-3-2012)

A 20" fir stump with opened blaze bears S.67°45'E., 21.1 ft to a cotton gin spike set in the center of the stump. (Found same condition on 8-3-2012)

A 50" fir stump with bark blaze visible bears S.55°E., 23.3 ft. (Found same condition on 8-3-2012)

10" D. Fir bears N.46°15'W., 15.3 ft scribed "1/4 S26 BT". (Found 11" with healed face on 8-3-2012)

11" D. Fir bears S.25°45'W., 13.3 ft scribed "1/4 S34 BT". (Found 12" with healed face on 8-3-2012)

A 5/8"x30" iron rod with plastic cap mkd "BTSENG-SURV" bears S.67°36'00"E., 19.08 ft. (Found good condition on 8-3-2012)

A 5/8"x30" iron rod with plastic cap mkd "BTSENG-SURV" bears S.49°12'08"E., 15.27 ft. (Found good condition on 8-3-2012)

Monument Detail

Sketch

Monument Set (Procedures and Description)

None

New Accessories

Location & Comments

Surveyor's Seal

Corner has steel post Compass Declination 16° East

adjacent to it. Firm/Agency Northwest Land


All BT's have red painted Surveying Inc.

bands and yellow tags. Address P.O. Box 2827  
Florence, OR 97439


Party Chief Ron Rice

Notes \_\_\_\_\_

Witness Jason Collver

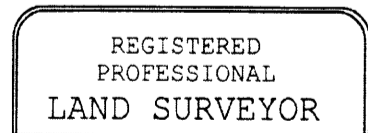

*Ronald L. Rice*

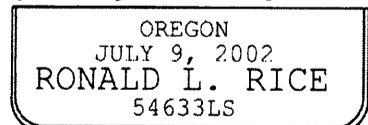

RENEWS: 12-31-2012

C.S. FILE 65/77-20