

Date: 8/28/2012 By: JC

This survey consists of:

~~Map:~~ This corner report was downloaded
from the Jackson Co. Surveyor's
Office web site 8/28/2012

~~Narrative:~~
Corner Rpt: C.S. 65/77-30

DOUGLAS COUNTY
SURVEYOR

FIRST RE-ESTABLISHMENT

Section corner common to Sec. 11,12,13 and 14, Twp. 30 South,

Range 3 East, W.M. $V=17\frac{1}{2}^\circ$

Fd., original 2 ins. (5 cm.) diam. iron pipe, projecting 5 ins.

(13 cm.) with G.L.O. brass cap mkd:

T30S R3E

S11 S12

S14 S13

1928

Original bearing trees recorded by H.Raymond in 1928 fd. as follows:

Douglas fir, 24 ins. (61 cm.) diam. with healed single blaze, brs. $N10^\circ E$, 36.05 ft. (10.99 m)
to center. Record: $N11\frac{1}{2}^\circ E$, 36.30 ft. (11.06 m.).

White pine snag, 17 ins. (43 cm.) diam., with healed single blaze, brs. $S42^\circ E$, 15.82 ft. (4.82 m.)
to center. Record: $S42^\circ E$, 15.18 ft. (4.63 m.).

Cedar, 22 ins. (56 cm.) diam., with healed single blaze, brs. $S1\frac{1}{2}^\circ W$, 73.85 ft. (22.51 m.) to
center. Record: $S2\frac{1}{2}^\circ W$, 73.26 ft. (22.33 m.)

White fir, 31 ins. (79 cm.) diam., with healed single blaze, brs. record; $N85^\circ W$, 73.26 ft. (22.33
m.) to center.

I mk a new tree CS BT:

Hemlock, 13 ins. 33 cm.) diam., brs. $S74^\circ E$, 19.90 ft. (6.07 m.) to center of tree at lower blaze.

Corner lies at east edge of swampy brush field.

November 14, 1977

B.Malotte

Approved by: Ed McGinty

R.Frost

Co. Surveyor

SEE NEXT PAGE FOR SECOND RE-ESTABLISHMENT


C.S. FILE: 65/77-30

SECOND RE-ESTABLISHMENT

GCDB 600500

Section corner common to Sections 11, 12, 13, and 14 of Township 30 South, Range 3 East, W.M.

Found at the corner position, exposed 5 ins., the 1 in. diam. galv. iron pipe with a 2½ ins. diam. brass cap set by the GLO in 1928 and marked:

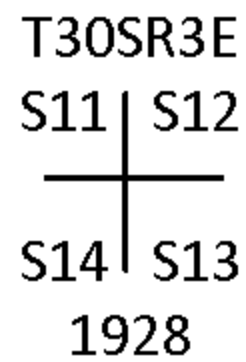

Original bearing trees recorded by H. Raymond of the GLO in 1928 found with healed blazes and measured to center at base;

- D. fir now 33 ins. diam. brs. record N10°E, 36.1 ft.
- W. pine dead and down brs record S42°E, 15.8 to center of stump hole.
- Cedar now 31 ins. diam. brs. record S1½°W, 73.8 ft.
- W. fir snag brs. record N85°W, 73.2 ft.

Marked new bearing trees 'CS''BT' and measured to center at lower blaze;

- W. fir 7 ins. diam. brs. N23°W, 30.7 ft.

Corner lies approx. 800 ft. westerly from gravel road at northerly edge of swampy area.

August 27, 2009

B. Beeman

H. Durkee

Kerry K. Bradshaw
Jackson County Surveyor

P. -198

V. - 14°