

OREGON CORNER RESTORATION FORM

FILED
Date: 9/18/2012 By: JC
This survey consists of:
Map: _____
Narrative: _____
Corner Rpt: CS 65/77-39

Section 32 Township 24 South, Range 2 West
County Douglas Date 6 September 2012

DOUGLAS COUNTY
SURVEYOR

Corner Description

SE Corner
Section 32

- Condition Report Only
- Not Found
- Renewed
- Unrecorded
- Surveyed In
- Referenced Out

Previous Renewals / Surveys, etc.

Monument (s) & Accessories Found: (Condition and Source)

- Found 2" dia. Iron post with BLM brass cap dated 1963 and 1978 with 1-1/2" iron pipe alongside 58" Fir stump, S.88°E., 9.0 ft. with "W" nail & plate. (Found 58" stump with nail and plate)
- A 54" stump, with rescribing "T24S R2W S33 BT" visible on unhealed blaze, bears N.65°E., 23.8 ft. (Found 54" stump with scribing visible)
- A 37" snag, no scribing found, bears S.42°W., 49.5 ft. (Found 37" stump)
- A 20" Yew with faint scribing "B" visible on orig. blaze and rescribing "T24S R2W S32 BT" visible on unhealed blaze, bears N.26½°W., 16.5 ft. (Found 20" Yew with scribing visible)
- A 20" Yew "W" nail bears S.20°W., 30.1 ft. (Found 23" Yew with nail)

Monument Detail

Sketch

Monument Set (Procedures and Description)

None


New Accessories

- 15" D. Fir bears S18°E 25.5 ft., scribed T25S R2W S4 BT
- 12" Hemlock bears N46°E 19.1 ft., scribed T24S R2W S33 BT

Location & Comments

Corner has steel post adjacent to it. Compass Declination 16° East
All BT's have red painted bands and yellow tags. Firm/Agency Northwest Land Surveying Inc.
 Address P.O. Box 2827
Florence, OR 97439
 Party Chief Ron Rice
 Notes _____
 Witness Jason Collver

Surveyor's Seal

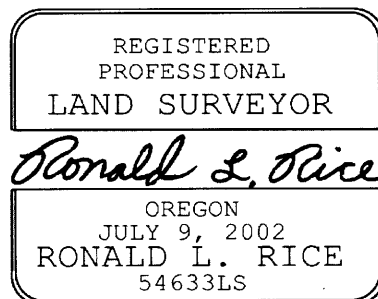

RENEWS: 12-31-2012

C.S. FILE 65/77-39