

CORNER REPORT FORM

Section 9 Township 29S Range 7W
Douglas County Date 10/10/2012

CORNER DESIGNATION

Center 1/4 Corner

- Condition Report only
- Not Found
- Renewed
- Unrecorded
- Surveyed In
- Referenced out

Previous Renewals/Surveys, etc:

Set on 1955 G.L.O. survey by Thielsen.
Found on my survey M 155-3.

Monument(s) & Accessories Found: (Condition and Source)

Found 1955 G.L.O. Brass Cap/Iron Pipe in good condition.

M 155-3 B.T.'s: 12" diam./5.5' tall stump bears N.79°E. (S.79°W.), 9.5'.(scribe visible).
(both Firs) 9" diam./48" tall stump bears S.5°W., (N.5°E), 25.7'. (scribe visible).


FILED

Monument Detail

Sketch

Date: 10/16/2012 By: JC
This survey consists of:
Map:
Narrative:
Corner Rpt: CS 65/77-44

DOUGLAS COUNTY
SURVEYOR

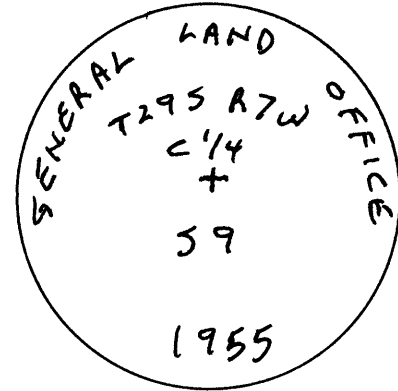

Monument Set (Procedures and Description)

N/A

New Accessories

Set three 5/8" x 30" steel rebars with red plastic caps mkd. "D.A. EDWARDS-LS 2339" as follows: N.43°E., 25.0'
S.43°W., 25.0'
N.20°W., 11.15'


A 6 foot steel post is set East 1.5'

Location & Comments

Corner lies 120' +/- North of outline in clearcut.

Surveyor's Seal

Compass Declination 18° East
Firm/Agency: David Edwards, L.S.
P.O. Box 361
Address: Oakland, OR. 97462
(541) 459-0512
Party Chief: David Edwards
Notes: Brant Miller
Witness:

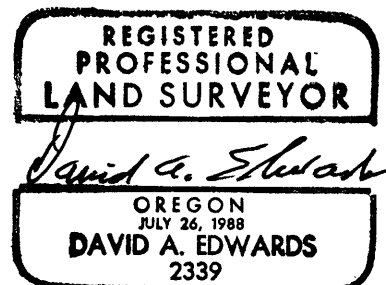

C.S. File No 65/77-44

Renews 12/31/2012