

CORNER REPORT FORM

Section 9 Township 29S Range 7W
Douglas County Date 10/10/2012

CORNER DESIGNATION

CE 1/16 corner

- Condition Report only
- Not Found
- Renewed
- Unrecorded
- Surveyed In
- Referenced out

Previous Renewals/Surveys, etc:

G.L.O. survey by Thielsen in 1955. (set).
Found on my survey M 155-3 in 2008.

Monument(s) & Accessories Found: (Condition and Source)

Found 1955 G.L.O. Brass Cap/Iron Pipe in good condition.
22" diam. Fir w/healed blaze (48" tall stump) S.76°E., 57.4'. 1955 B.T.
9" diam. Fir w/scribe vis. (6' tall stump) N.65°E., rec. S.65°W., 11.9' M 155-3


FILED

Date: 10/10/2012 By: JL
This survey consists of: Monument Detail

Sketch

Map: _____
Narrative: _____
Corner Rpt: CSLS/77-45

DOUGLAS COUNTY
SURVEYOR

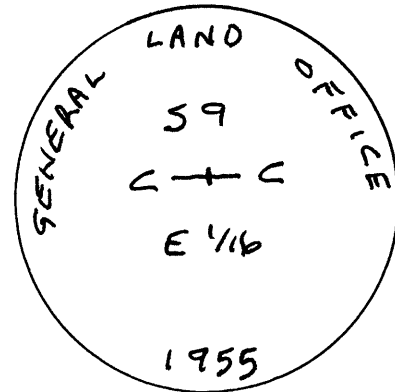

Monument Set (Procedures and Description)

N/A

New Accessories

Set a 5/8" x 30" steel rebar with red plastic cap mkd. "D.A. EDWARDS-LS 2339"
S.46°E., 81.90'. Rebar is just into the timber.

Scribe an 18" diam. Fir "CE 1/16 S9 BT" bears S.38°W., 46.9'. On the cut line.

Location & Comments

Corner lies 40' North
of a cut line in a
clearcut.

Surveyor's Seal

Compass Declination 18° East

Firm/Agency:

David Edwards, L.S.

Address: P.O. Box 361

Oakland, OR. 97462

(541) 459-0512

Party Chief:

David Edwards


Notes:

Brant Miller

Witness:



David A. Edwards

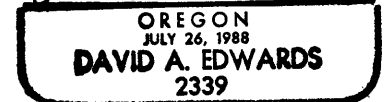

Renews 12/31/13

C.S. File No CSLS/77-45