

OREGON CORNER RESTORATION FORM

Section 22 Township 30 S. Range 9W  
County Douglas Date 10/19/12

FILED

Date: 10/23/2012 By: JC  
This survey consists of:  
Map: \_\_\_\_\_  
Narrative: \_\_\_\_\_  
Corner Rpt: CS 65/77-46

Corner Designation

T. 30 S. R. 9 W.  
S22  
1/4 —●—  
S27

- \_\_\_\_\_ Condition Report Only
- \_\_\_\_\_ Not Found
- X \_\_\_\_\_ Renewed
- \_\_\_\_\_ Unrecorded
- \_\_\_\_\_ Surveyed In
- \_\_\_\_\_ Referenced Out

DOUGLAS COUNTY  
SURVEYOR

Previous Renewals/Surveys, etc.

Original GLO Field Notes Field in Douglas County Surveyors Office Pg. 7419, Corner Renewal T. 30 S. R. 9 W. 440300, C. S. File 53/53


Accessories Found: (Condition and Source)

Original 5 Foot Sugar Pine Dead Snag No Bark on Tree Bears N 76°E 19.3 Ft. As Per Record, Healed Face  
Original 5 Foot Fir Bears Broken Missing Top Bears S48 1/4° E 10.4 Ft. As Per Record, Healed Face

Monument Detail

Sketch


5/8" I.R. With Orange Plastic Cap  
Marked Lone Rock Timber PLS 2291

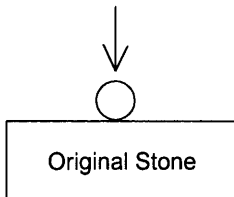

Legend:

- Found Original Stone
- /— Old Blazed Line

Logged in 1995 Plantation

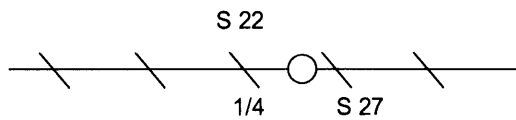

BLM Timber

Monument Found

Found Original 12" X 12" X 5" Stone With 1/4 Scribed on North Face

New Accessories

13" Douglas Fir Bears S31°W 34.1 Ft. We Scribe 1/4 S27 BT and Nail Aluminum Bearing TreeTag To The Tree  
21" Douglas Fir Bears S55°W 34.0 Ft. We Scribe 1/4 S27 BT and Nail Aluminum Bearing Tree Tag To The Tree  
Set 5/8" Iron Rod With Orange Plastic Cap Marked Lone Rock Timber PLS 2291 North 0.25 Ft. From Center of Stone  
Metal Fence Post Approx. North 0.75 Ft. From Original Stone

Location & Comments

Found original stone and bearing trees on steep easterly facing slope. We also looked for original line trees called for in GLO notes on south line of section 22 We use a Trimble GEO 6000 to check record bearings and distances. We found the original line tree called for at S89°43'E 7.83 chains from the 1/4 corner. This tree is now a 27" fir with visible marks from which a bearing tree bears N42°W 12.8 Ft. with healed face and BLM tag. Three original line trees clustered N89°43'W approx. 1 chain of the 1/4 corner are now blown over and burned but no conclusive line tree evidence. Original line tree N89°43'W 15.1 Chains from the 1/4 corner I find two 18" stumps near the record bearing and distance but no conclusive line tree evidence. Original line tree at N89°43'W 36.48 chains from 1/4 corner I find at record bearing and distance very rotten burned stump remains but no conclusive line tree evidence.

Bearing Basis Bearing is Magnetic

Firm/Agency Lone Rock Timber Co.

Address P. O. Box 1127  
Roseburg, Ore. 97470

Party Chief Ken W. Hoffine

Notes G. Angiolet

Witness G. Angiolet

REGISTERED  
PROFESSIONAL  
LAND SURVEYOR

*Ken W Hoffine*

OREGON  
JULY 16, 1987  
KEN W. HOFFINE  
PLS 2291

EXPIRES 6-30-13

C.S. File No 65/77-46