

CORNER REPORT FORM

Section 12 Township 25 S Range 3 W

Douglas County Date 12/14/2012

CORNER DESIGNATION

SW 1/16 Section 12

- Condition Report only
- Not Found
- Renewed
- Unrecorded
- Surveyed In
- Referenced out

Previous Renewals/Surveys, etc:

Set on M 68-32

FILED

Monument(s) & Accessories Found: (Condition and Source)

Found 3/4" diam. Iron Pipe.

NE BT is a stump. SE BT is gone.

Date: 1-2-2013 By: SC

This survey consists of:

Map: \_\_\_\_\_

Narrative: \_\_\_\_\_

Corner Rpt: CS 65/78-1

DOUGLAS COUNTY  
SURVEYOR

Monument Detail

Sketch

N/A

Monument Set (Procedures and Description)

N/A

New Accessories

This corner lies at the North edge of a large clearcut. There are no trees within a reasonable distance that would be useful as a bearing tree.

I set a 6 foot post 2 feet North with a location tag attached.


I set a 6 foot post 1 foot West. ( Steel channel posts ).

Location & Comments

Surveyor's Seal



*David A. Edwards*

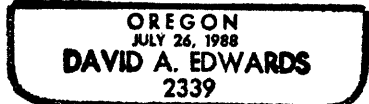

Renews 12/31/13

Compass Declination 17°

Firm/Agency: David Edwards Land Surveying  
P.O. Box 361

Address: Oakland, Oregon 97462  
(541) 459-0512

Party Chief: David Edwards

Notes: Brant Miller

Witness:

C.S. File No 65/78-1