


OREGON CORNER RESTORATION FORM

Section 6 Township 31 S. Range 4W
 County Douglas Date 2/14/13

FILED
 Date: 3-13-2013 By: JC
 This survey consists of:
 Map: _____
 Plan: _____
 Corner hpt: CS 65/78-10

Corner Designation

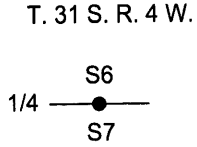

- _____ Condition Report Only
- _____ Not Found
- _____ X _____ Renewed
- _____ Unrecorded
- _____ Surveyed In
- _____ Referenced Out

DOUGLAS COUNTY
 SURVEYOR

Previous Renewals/Surveys, etc.

Original GLO Field Notes Filed in Douglas County Surveyors Office Vol. 19 Pg. 7871, 1959 Markham Survey
 Perpetuated 1/4 Corner From Original BT C. S. File 42/391, Hoffine Map M. 123-69


Accessories Found: (Condition and Source)

15" Douglas Fir Snag 6 Foot Tall Bears N52 1/4°W 21.4 Ft. (Record From M 123-69 N51 1/4°W 21.6 Ft.)
 Partial Visible Scribing And Tag
 22" Douglas Fir Bears S63 3/4°E 20.9 Ft. (Record From M 123-69 S64°E 20.9 Ft.) Healed Face And Tag
 17" Douglas Fir Bears S48°W 17.1 Ft. No Record Healed Face


Monument Detail

Sketch

TRUCK AXLE WITH FLANGE

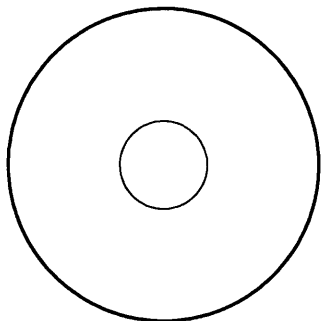

Legend:

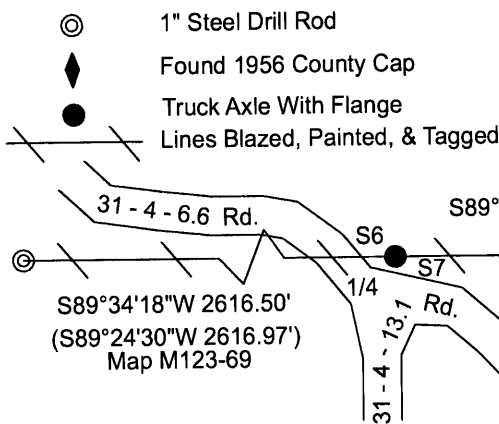

Monument Found
 Found Truck Axle With Flange

New Accessories

21" Douglas Fir Bears N72°E 22.4 Ft. We Scribe 1/4 S6 BT And tag Tree
 9" Douglas Fir Bears N42 1/4°W 24.6 Ft. We Scribe 1/4 S6 BT And Tag Tree

Location & Comments

Lone Rock Timber ran a random traverse along the section lines from the east 1/4 corner to the southeast corner to the south 1/4 to the southwest corner of section 6. to mark property lines for timber management purposes. We also ran a GPS survey for survey control at points on our conventional traverse to check closure. We marked the property lines with flagging, blazing, painting, and aluminum tags. Found axle with flange approx. 75 ft. north and east of road junction.

Bearing Basis Bearing is From GPS Observation
 Firm/Agency Lone Rock Timber Co.
 Address P. O. Box 1127
Roseburg, Ore. 97470
 Party Chief Ken W. Hoffine
 Notes G. Angiolet
 Witness G. Angiolet

REGISTERED
 PROFESSIONAL
 LAND SURVEYOR

Ken W. Hoffine
 OREGON
 JULY 16, 1987
 KEN W. HOFFINE
 PLS 2291

EXPIRES 6-30-13

C.S. File No 65/78-10