

CORNER REPORT FORM

Section 32 Township 24 S Range 2 W
Douglas County Date March 20, 2013

CORNER DESIGNATION

Corner common to Sections 31 and 32,
T24S, R2W and Sections 5 and 6,
T25S, R2W

___ Condition Report only
___ Not Found
X Renewed
___ Unrecorded
___ Surveyed In
___ Referenced out

Previous Renewals/Surveys, etc:

Original 1883 John A. McQuinn
B.L.M. resurvey by Levi E. Tallett and C. Albert White 1951/1963

Monument(s) & Accessories Found: (Condition and Source)

Found 1951 B.L.M. brass cap in mound of stones.
The original bearing trees are all stumps.
The 1951 Yew B.T. is down.
A 19" diam. Hemlock with healed blaze bears S.68°E., 60.1 feet.
A 27" diam. Hemlock with healed blaze bears N.12 1/4°W., 56.1 feet.
Both are 1951 B.L.M. bearing trees.

FILED

Monument Detail

Sketch

Date: 3/28/2013 By: JC

This survey consists of:

Map: _____


Narrative: _____

Corner Rpt: CS 65/78-12

DOUGLAS COUNTY
SURVEYOR

Monument Set (Procedures and Description)

N/A

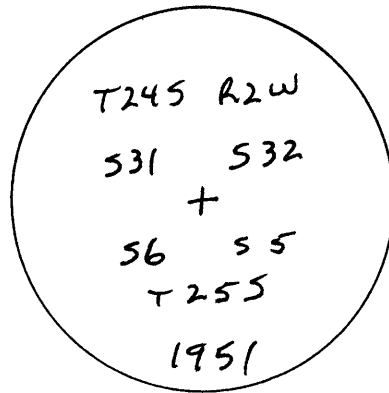

New Accessories

An 8" diam. Fir scribed "T24S R2W S32 BT" bears N.72°E., 35.8 feet.

A 9" diam. Fir scribed "T25S R2W S6 BT" bears S.22°W., 32.0 feet.

A 6 foot steel post is set 2.5 feet N.85°E.

Location & Comments

Surveyor's Seal

Compass Declination 18° East

Firm/Agency:

David Edwards Land Surveying
P.O. Box 361


Address:

Oakland, Oregon 97462 (541) 459-0512

Party Chief: Brant Miller

Notes:

Witness: Eric Sprinkle

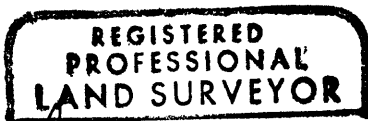

David A. Edwards
OREGON
JULY 26, 1988
DAVID A. EDWARDS
2339

Renews 12/31/13

C.S. File No 65/78-12