

CORNER REPORT FORM

Section 32 Township 28 S Range 8 W  
Douglas County Date March 25, 2013

CORNER DESIGNATION

South 1/16 corner common to  
Sections 31 and 32

\_\_\_ Condition Report only  
\_\_\_ Not Found  
X Renewed  
\_\_\_ Unrecorded  
\_\_\_ Surveyed In  
\_\_\_ Referenced out

Previous Renewals/Surveys, etc:

B.L.M. 1964 Dependent Resurvey

Monument(s) & Accessories Found: (Condition and Source)


Found 1964 B.L.M. Brass Cap. Both 1964 bearing trees are gone.

Monument Detail

Sketch

FILED

Date: 3/28/2013 By: JC  
This survey consists of:  
Map: \_\_\_\_\_  
Narrative: \_\_\_\_\_  
Corner Rpt: CS 65/78-13

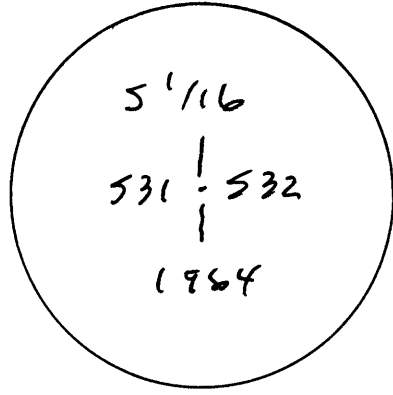

DOUGLAS COUNTY  
SURVEYOR

Monument Set (Procedures and Description)

N/A

New Accessories


A 15" diam. Fir scribed S 1/16 S32 BT bears N.25°E., 38.0 feet.  
A 6" diam. Fir scribed S 1/16 S31 BT bears N.10°W., 11.15 feet.

Location & Comments

Surveyor's Seal



*David A. Edwards*

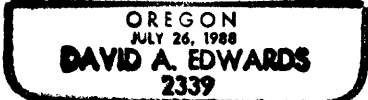

Renews 12/31/13

Compass Declination 18° East

Firm/Agency: David Edwards Land Surveying  
P.O. Box 361  
Address: Oakland, Oregon 97462  
Phone: (541) 459-0512

Party Chief: Brant Miller

Notes: Eric Sprinkle

Witness:

C.S. File No 65/78-13