

CORNER REPORT FORM
 Section 26 Township 24S Range 2W
 Douglas County Date 4-1-13
 CORNER DESIGNATION 540240

___ Condition Report
 ___ Not Found
X Renewed
 ___ Unrecorded
 ___ Surveyed In
 ___ Referenced out

Previous Renewals/Surveys, etc:
 CORNER RENEWAL #540240
 M12-55

Monument(s) & Accessories Found: (Condition and Source)
 FOUND HEMLOCK SNAG SCRIBED "1/4 S 26 PS (UNREADABLE) BT" - TREE WAS BLAZED & SCRIBED "1/4 S26 PS253 BT" PER M12-55



Monument Detail

5/8" x 30" IRON ROD WITH ALUMINUM CAP STAMPED
 "ROSEBURG RESOURCES COMPANY"


Monument Set (Procedures and Description)

Sketch

COULD NOT FIND ORIGINAL MONUMENT, BUT DID FIND ONE ORIGINAL BT AS NOTED ABOVE. THERE WAS NO EVIDENCE OF THE OTHER BT (12" CEDAR) OF RECORD. THE ONLY OTHER TREE IN THAT VICINITY WAS A 54" FIR STUMP THAT BEARS S 79 W 23.3 FEET FROM THE RENEWED CORNER. CORNER WAS SET RECORD BEARING AND DISTANCE FROM THE HEMLOCK SNAG FOUND WITH ORIGINAL SCRIBING PER M12-55.

New Accessories

13" FIR BLAZED & SCRIBED "C 1/4 S 26 BT"
 BEARS N60°13'W 23.2 FEET
 14" FIR BLAZED & SCRIBED "C 1/4 S 26 BT"
 BEARS N43°19'E 22.1 FEET
 10" FIR BLAZED & SCRIBED "C 1/4 S 26 BT"
 BEARS S32°42'E 16.8 FEET
 19" FIR BLAZED & SCRIBED "C 1/4 S 26 BT"
 BEARS S37°06'W 15.7 FEET

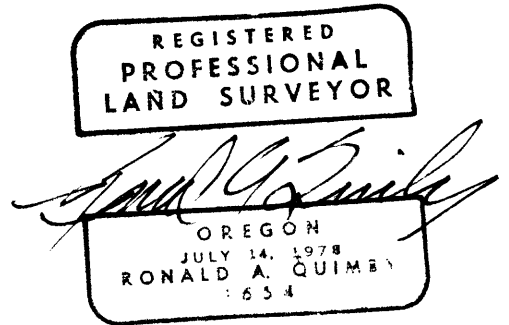

Surveyor's Seal

Location & Comments

CORNER IS LOCATED ON THE EASTERLY SIDE OF A VERY STEEP DRAW WITH WINDFALL TREES SURROUNDING IT. GROUND IS SOMEWHAT ROCKY & HAS BEEN LOGGED IN THE PAST	Compass Declination 15.5° Firm/Agency: ie Engineering, Inc. Address: 809 S.E. Pine St. Roseburg, OR. 97470 Party Chief: Jeremy Leonard Notes: Witness: Derek Feigel, Nolan Fromdahl
--------------------------------------------------------------------------------------------------------------------------------------------------------------------------	-------------------------------------------------------------------------------------------------------------------------------------------------------------------------------------------------------

N.W COR
 N 1/4 COR.
 Sec 26
 FOUND OK.
 3/13
 [Signature]

FILED
 Date: 4-10-2013 By: JC
 This survey consists of:
 Map: _____
 Narrative: _____
 Corner Rpt: CS 65/78-23

DOUGLAS COUNTY
 SURVEYOR

C.S. File No 65/78-23