

CORNER REPORT FORM

Section 2 Township 30S Range 8 W

Douglas County Date 4/4/2013

CORNER DESIGNATION

1/4 corner common to  
Sections 1 and 2

- Condition Report only
- Not Found
- Renewed
- Unrecorded
- Surveyed In
- Referenced out

Previous Renewals/Surveys, etc:

Original: W.H. Byars in 1882. 1965 Douglas County Surveyor renewal.

Monument(s) & Accessories Found: (Condition and Source)

Found 1965 D.C.S. Brass Cap in good condition.

The Fir S.60°W. is a snag.

Find a 25" diam. Cedar w/healed blazes S.45°E., 14.8'

FILED

Date: 4-10-2013 By: SC

This survey consists of:

Map: \_\_\_\_\_


Narrative: \_\_\_\_\_

Corner Rpt: CS 65/78-24

DOUGLAS COUNTY  
SURVEYOR

Monument Detail

Sketch

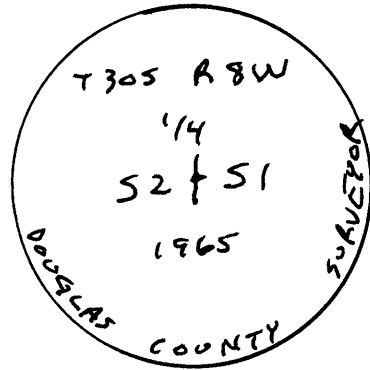

Monument Set (Procedures and Description)

N/A

New Accessories

An 8" diam. Fir scribed "T30S R8W S1 BT" bears N.45°E., 19.8'

A 15" diam. Cedar scribed "T30S R8W S2 BT" bears South, 18.7'

A 10" diam. Fir scribed "T30S R8W S2 BT" bears S.29°W., 26.7'

A six foot steel post is set 2' South

Location & Comments

Surveyor's Seal

Compass Declination 16° East

Firm/Agency: David Edwards Land Surveying

P.O. Box 361

Address:

Oakland, Oregon 97462

Phone: (541) 459-0512


Party Chief:

Brant Miller

Notes:

Witness:

Eric Sprinkle

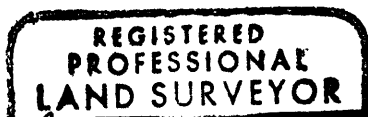

*David A. Edwards*

OREGON  
JULY 26, 1988  
DAVID A. EDWARDS  
2339

Renews 12/31/13

C.S. File No 65/78-24