

FILED MAY 10 2013

1/4 CORNER 9/10


T30SRBW

FOUND OK

5-8-13

DIETZGEN NO. 386-S

REGISTERED
PROFESSIONAL
LAND SURVEYOR

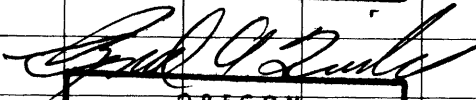

OREGON
JULY 14, 1978
RONALD A. QUIMBY
1854

12-31-14

C.S. File No 65/78-39