

OREGON CORNER RESTORATION FORM

Section 28 Township 28 S. Range 4W
County Douglas Date 5/14/13

FILED
Date: 5/30/2013 By: JC
This survey consists of:
Map: _____
Narrative: _____
Corner Rpt: CS 65/78-43

Corner Designation

T. 28 S. R. 4 W.
1/4
S21
●
S28

- _____ Condition Report Only
- _____ Not Found
- _____ X _____ Renewed
- _____ Unrecorded
- _____ Surveyed In
- _____ Referenced Out

DOUGLAS COUNTY SURVEYOR


Previous Renewals/Surveys, etc.

BLM resurvey by Zirpel and Glen, under Special Instructions dated August 29, 1957 (DCSO records, Vol. 29 Page 12250),
R. Brown M116-52 dated Jan. 1993

Accessories Found: (Condition and Source)


26" Douglas Fir Bears N31 1/4°W 55.77 Ft. As Per Record Healed Face And Tag
Rotten Remains Of Douglas Fir Bears S7 3/4°W 46.2 Ft. As Per Record No Marks Found

Monument Detail

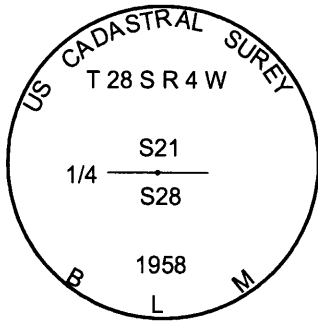

Legend:

- Found 1958 BLM Cap
- ⊙ Found 5/8" Iron Rod As Per Holt in Map M65-25
- Found 1 1/2" Iron Pipe As Per Holt in Map M65-25
- /— Lines Blazed, Painted, & Tagged

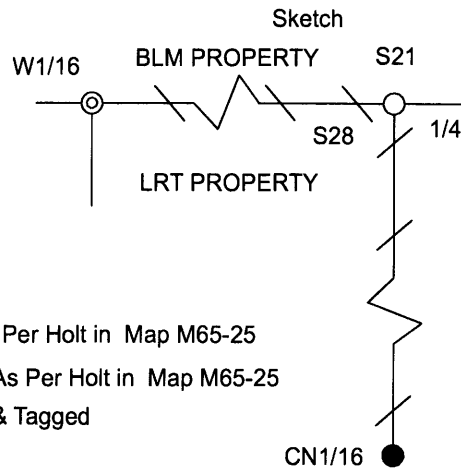

Monument Found

Found 1958 BLM Cap At Ground Level.

New Accessories

14" Douglas Fir Bears S59°E 16.9 Ft. We Scribe 1/4 S28 BT and Nail Aluminum Bearing Tree Tag To The Tree

Location & Comments

Corner lies on steep southwest slope. We have reblazed property lines to the south and west with red property line and flo blue flagging, and painted blazes with flo red paint.

Bearing Basis Magnetic Compass Bearing

Firm/Agency Lone Rock Timber Co.

Address P. O. Box 1127
Roseburg, Ore. 97470

Party Chief Ken W. Hoffine

Notes G. Angiolet

Witness G. Angiolet

REGISTERED
PROFESSIONAL
LAND SURVEYOR

Ken Hoffine

OREGON
JULY 16, 1987
KEN W. HOFFINE
PLS 2291

EXPIRES 6-30-13

C.S. File No 65/78-43