

OREGON CORNER RESTORATION FORM

Section 28 Township 28 S. Range 4W  
 County Douglas Date 5/14/13

**FILED**  
 Date: 5/30/2013 By: JC  
 This survey consists of:  
 Map: \_\_\_\_\_  
 Reference: \_\_\_\_\_  
 Corner Rpt: CS 65/78-44

Corner Designation

T. 28 S. R. 4 W.  
 CN 1/16



- \_\_\_\_\_ Condition Report Only
- \_\_\_\_\_ Not Found
- \_\_\_\_\_ X Renewed
- \_\_\_\_\_ Unrecorded
- \_\_\_\_\_ Surveyed In
- \_\_\_\_\_ Referenced Out

**DOUGLAS COUNTY  
 SURVEYOR**

Previous Renewals/Surveys, etc.


Holt Map M65 -25, Brown Maps M116-52 & m120-63, & Lang Map M139-62.

Accessories Found: (Condition and Source)

15" White Fir Bears N77°E 13.4 Ft. (Record N68°E 13.8 Ft.) Healed Face And Tag  
 Rotten Remains Of Fir Bears S86°W 3.5 Ft. As Per Record


Monument Detail

1 1/2" Iron Pipe

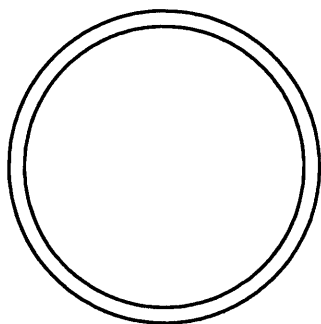

Legend:

- Found 1958 BLM Cap
- ⊙ Found 5/8" Iron Rod As Per Holt in Map M65-25
- Found 1 1/2" Iron Pipe As Per Holt in Map M65-25
- / — Lines Blazed, Painted, & Tagged

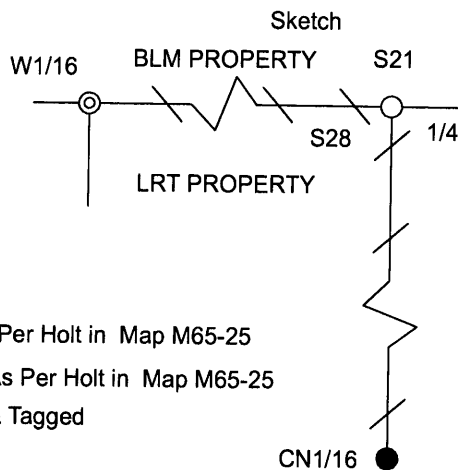

Monument Found

Found 1 1/2" Iron Pipe As Per Holt Map M65-25

New Accessories

14" White Fir Bears N27°W 7.2 Ft. We Scribe CN1/16 S28 BT and Nail Aluminum Bearing Tree Tag To The Tree

Location & Comments

Corner lies on east facing slope, on north side of main ridge and approx, 50 ft. north of old skid road. Have reblazed the line running north from center north 1/16 corner with red property line and flo blue flagging, and painting blazes with flo red paint.

Bearing Basis Magnetic Compass Bearing  
 Firm/Agency Lone Rock Timber Co.  
 Address P. O. Box 1127  
Roseburg, Ore. 97470  
 Party Chief Ken W. Hoffine  
 Notes G. Angiolet  
 Witness G. Angiolet

REGISTERED  
 PROFESSIONAL  
 LAND SURVEYOR

*Ken Hoffine*

OREGON  
 JULY 16, 1987  
 KEN W. HOFFINE  
 PLS 2291

EXPIRES 6-30-13 **C.S. File No** 65/78-44