

FILED

Date: 1-29-2013 By: J.C.

This survey consists of:

Map: CS 65/79-1

Narrative: _____

Corner Rpt: _____

DOUGLAS COUNTY
SURVEYOR

BOUNDARY LINE SURVEY
THE WEST LINE OF THE SW1/4 OF THE NW1/4 OF SECTION 15.
T.29S.. R.8W.. W.M.. DOUGLAS COUNTY, OREGON

SURVEYED FOR:

SENECA JONES TIMBER COMPANY
P.O. BOX 2129
ROSEBURG, OR 97470


SURVEY BY:

MULKINS & RAMBO, LLC
P.O. BOX 809
NORTH BEND, OR 97459

REGISTERED
PROFESSIONAL
LAND SURVEYOR

Troy Rambo
OREGON
JULY 14, 1998
TROY J. RAMBO
2865

RENEWAL 12-31-14

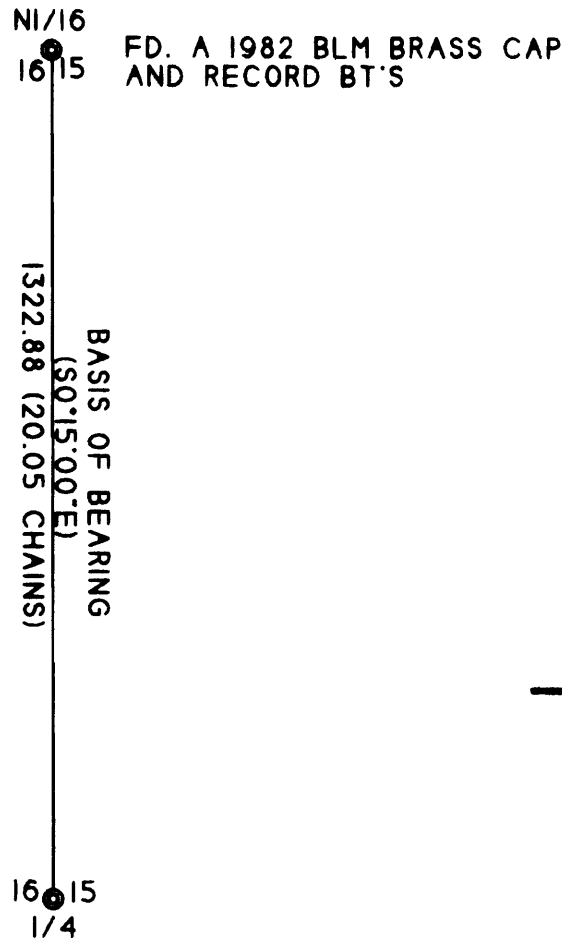

BASIS OF BEARING
BLM - TRUE BEARINGS
JANUARY 25, 2013
SCALE 1" = 300'

LEGEND

● FD. CORNER AS SHOWN

— LINES MARKED WITH 5 1/2' FENCE
POSTS. BLAZED AND FLAGGED

() RECORD BEARING / DISTANCE

NARRATIVE

FD. A 1982 BLM BRASS CAP
AND RECORD BT'S - SET A
5 1/2' FENCE POST 1.5' NORTH

THE PURPOSE OF THIS SURVEY WAS TO MARK THE LINE SHOWN FOR FUTURE FOREST OPERATIONS.
CONTROL FOR THIS SURVEY WAS BASED ON THE 1983 DEPENDENT RESURVEY AND SUBDIVISION OF
SECTION 15.

THE FIELD WORK WAS PERFORMED ON JANUARY 24, 2013 WITH THE ASSISTANCE OF CLYDE MULKINS.

C.S. File No 65/79-1