

MAP OF SURVEY

FILED

Date: 7/31/2013 By: NW
 This survey consists of:
 Map: CS 65/79-11
 Narrative: _____
 Corner Rpt: _____

LOCATED in the NW 1/4 of
 Section 6, T. 22 S., R. 4 W., W.M.
 in Douglas County, Oregon.

DOUGLAS COUNTY
 SURVEYOR


July 17, 2013

SURVEYED FOR: *SENECA JONES TIMBER CO.*
P.O. BOX 10265
EUGENE, OREGON 97440



David A. Edwards

SURVEYED BY: *DAVID EDWARDS LAND SURVEYING*
P.O. BOX 361
OAKLAND, OREGON 97462
PHONE: (541) 459-0512

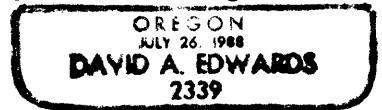

RENEWS 12/31/13

LEGEND

⊙ INDICATES BRASS CAP FOUND.

() DENOTES RECORD DATA.

SCALE: 1" = 1000'

————— INDICATES LINE POSTED AND BLAZED THIS SURVEY.

BASIS OF BEARINGS: M 42-68 AS SHOWN.

NARRATIVE

THE PURPOSE OF THIS SURVEY IS TO MARK THE LINES SHOWN AS BOLD HEREON. THE LINES WERE MARKED BY BLAZING TREES ON EACH SIDE OF LINE, BY SETTING 6 FOOT STEEL POSTS ALONG THE LINE AT INTERVALS OF 200' OR LESS AND BY HANGING LIBERAL AMOUNTS OF RED FLAGGING ALONG THE TRUE LINE.

TOWNSHIP CORNER
 44" FIR N. 43 1/4° E., 27.7'
 37" FIR S. 25° E., 5.9'
 41" FIR S. 20 3/4° W., 61.4'
 37" FIR STUMP N. 10° W., 52.1'
 SET 6 FOOT STEEL POST 2' SOUTH

WEST 1/16 CORNER
 23" FIR N. 7° E., 25.7'
 12" FIR STUMP S. 19° W., 20.5'
 NEW B.T. SCRIBED "W 1/16 S6 BT":
 9" FIR S. 67° W., 10.4'
 FOUND STEEL FENCE POST 0.7' WEST

