

FILED

OREGON CORNER RESTORATION FORM

Date: 9/10/2013 By: JC

This survey consists of:

Map: _____

Narrative: _____

Corner Rpt: CS 65/80-4

Section 16 Township 19 South, Range 8 West

County Douglas

Date 10 September 2013

DOUGLAS COUNTY
SURVEYOR

Corner Description

1/4 Corner

Sections 16, 17

Condition Report Only

Not Found

Renewed

Unrecorded

Surveyed In

Referenced Out

Previous Renewals / Surveys, etc.

Monument (s) & Accessories Found: (Condition and Source)

Found 2-1/2" GLO brass cap, dated 1952, with the following accessories:

Fir, 19" dia., bears N.37°E., 31 lks., mkd. with an old blaze on SW face.

(Found 27" Fir with healed face)

Fir, 32" dia., bears N.73½°W., 22 lks., with old blaze on SE face.

(Found 32" Fir stump with healed face)

Fir, 36" dia., bears N.86½°E., 94 lks., mkd: 1/4 S16 BT.

(Found 66" Fir with healed face)

Alder, 10" dia., bears S.64°W., 40 lks., mkd: 1/4 S BT.

(Missing)

Monument Detail

Sketch

Monument Set (Procedures and Description)

None

New Accessories

None

Location & Comments

Corner has steel post Compass Declination 16° East

adjacent to it. Firm/Agency Northwest Land

All live BT's have red painted Surveying Inc.


bands and yellow tags. Address P.O. Box 2827
Florence, OR 97439

Party Chief Ron Rice


Notes _____

Witness _____

Surveyor's Seal

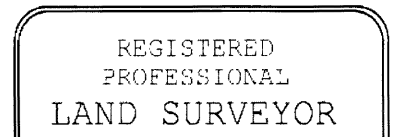

Ronald L. Rice

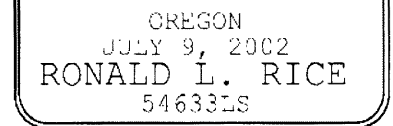

RENEWS: 12-31-2014