

LANE COUNTY
DEPARTMENT OF PUBLIC WORKS

RESTORED CORNER

FILED OCT 16 2013
INDEX NO. _____

CORNER Section Corner, T. 19 S., R. 9 W, W.M.
G.L.O. NOTES DATED: _____ BY: _____

CORNER: _____
ACCESSORIES: _____

REESTABLISHMENT NOTES DATED: _____ BY: _____
EVIDENCE RECOVERED: _____

FILED
Date: 12-16-2013 By: J.C.
This survey consists of _____
Rep: _____
Name: _____
Corner Rpt: LS 65/80-7

CORNER SET: _____
ACCESSORIES ESTABLISHED: _____

REESTABLISHMENT NOTES DATED: _____ BY: _____
EVIDENCE RECOVERED: _____

DOUGLAS COUNTY
SURVEYOR

CORNER SET: _____
ACCESSORIES ESTABLISHED: _____

REESTABLISHMENT NOTES DATED: _____ BY: _____
EVIDENCE RECOVERED: _____

CORNER SET: _____
ACCESSORIES ESTABLISHED: _____

REMONUMENTATION


DATE: May 2002 BY: Rob Ward TITLE: President FIRM: Wood NorthWest Inc.

EVIDENCE RECOVERED: 2-1/2" dia. Brass Cap dated 1958
26" X 6" Fir Stump bears N 9° E, 49 lks "Scribing Visible"
45" X 6" Metal Capped Fir Stump bears S 57° E 193 lks "Scribing Visible"
26" X 8" Fir Stump bears S 30° W, 12 lks "Scribing Visible"
22" Fir is missing

CORNER SET: N/A

ACCESSORIES ESTABLISHED:
10" Fir bears S 43° W, 23.2 FT Scribed "T19S R9W S14 BT"
13" Hemlock bears N 18° 31' 4" E, 29.4 FT Scribed "T19S R9W S12 BT"
17" Hemlock bears N 26° W, 31.1 FT Scribed "T19S R9W S11 BT"
14" Hemlock bears S 35° E, 20.0 FT Scribed "T19S R9W S13 BT"

OTHER INFORMATION: _____

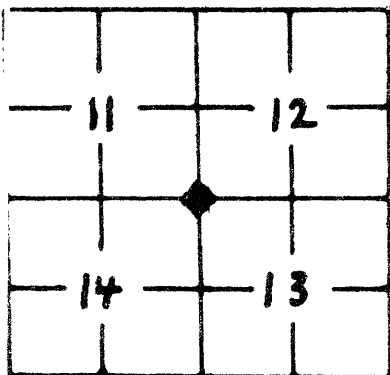

SECTION DIAGRAM

T 19 S R 9 W
S 11 | S 12
S 14 | S 13
1958

VERMONT

REGISTERED PROFESSIONAL LAND SURVEYOR
<i>Robert B. Ward Jr.</i>
OREGON ROBERT B. WARD JR. JULY 10 1958 1091
Expires 6-30-04 ORS 672-025

C.S. File No 65/80-7